

Name *HAMILTON COMPANY*

Service No.

Address *#8 BAKER AVENUE*

Location

Kind of Pipe

Size

Size of Main

Repair—Renewal

New Service

PERMIT NO. 0449 - MCLAUGHLIN

Location

Date

Material

Amount

Total

Date

Amount

3/31/95


6" ϕ P.V.C.

DATE 31 MARCH 1995

TOWN OF LEXINGTON — BOARD OF PUBLIC WORKS
SEWER DIVISION

Sketch of Service Here

8

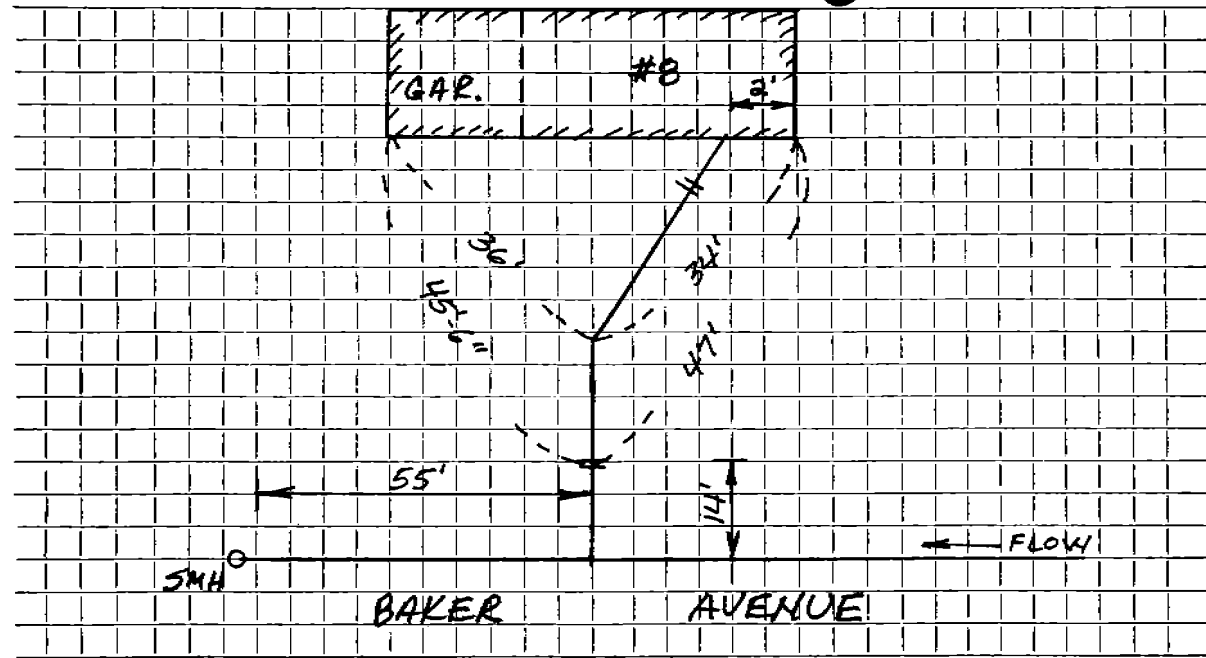

Connection made in BAKER AVENUE Street. Work completed J.M. MCLAUGHLIN

Remarks:

BOOK 96A

J.W.