

Name John C. Hilton

Service No. 99

Address 80 Baker Ave.

Lexington, Mass.

Location

Kind of Pipe

Size

Size of Main

~~Repair/Reconnect~~ New Service

Location

Date	Material	Amount	Total	Date	Amount
July 27, '48	Labor	40 15	40 15	July 8 '48	125 00
	10% Overhead		4 02	Dec. 31 '48	27 37
	42'-6" Sewer Pipe @ .26		10 92		<u>97 61</u>
	Joint Compound		2 52		
	3½ hrs. Littlefield Shovel		24 50		Received in
	2 hrs. Trucking		1 50		Street
	Patching 14 x 3		14 00		15'-6" PVC
			<u>97 61</u>		2-6" CI-PVC Fernco's
	Labor				
				10/15/68	Salts
				723-74	Roots

**TOWN OF LEXINGTON—DEPT. OF PUBLIC WORKS**  
**SEWER DIVISION**

DATE .....

NO. ....

The undersigned applies for the construction of a particular sewer connecting No. ....  
 Street and hereby agrees to comply with the Rules and Regulations governing the construction and use of Particular  
 Sewers, as now or at any future time established by the Board of Selectmen.


Am't of estimate \$.....

Am't Paid \$.....

..... Owner

Sketch of Service Here

80

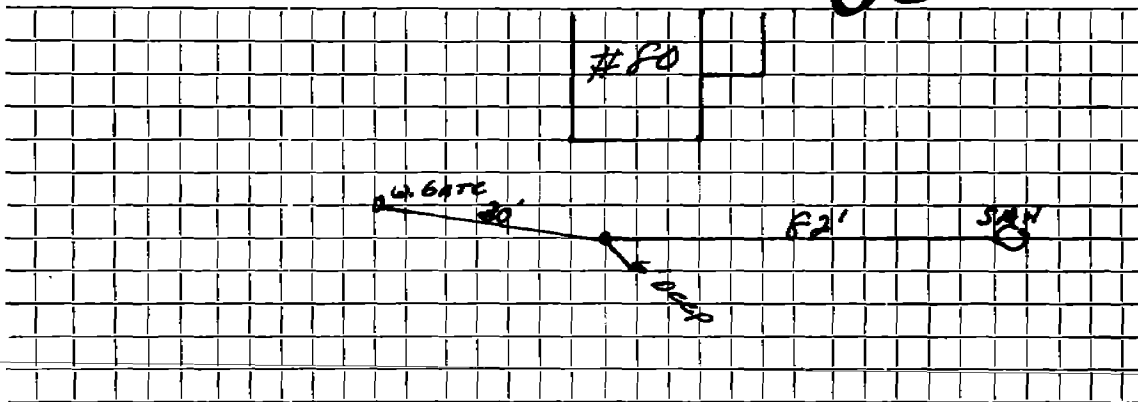

Connection made in ..... Street.

Work completed ..... 19..

Remarks: