

Name John Hilton

Service No. ³⁴ 2 - 1944

Address ⁸⁴ Baker Ave.,

Location 84 Baker Avenue

Kind of Pipe

Size

Size of Main

~~Repair-Renewal~~ - New Service

Location

Date	Material	Amount	Total	Date	Amount
April 20, '44	Labor	45 00		Mar 18 1944	40 00
21	"	13 70		Apr. 18 1944	80 00
	10% Overhead	<u>5.87</u>	64 57		120 00
	Trucking 3 hrs. @ .75		2 25	April 24 '44	36 09
	62' 6" V.C. @ .16		9 92		83 91
	1 - 1/8 Bend		67		
	5' - Cast Iron Soil Pipe @ .50		2 50		
	Joint Compound		<u>4 00</u>		
			83 91		
	Excavating and back filling on private property done by owner.				
	Labor			12-12-47	Salids 20' 04'

Hadley Press, Inc., Lexington

TOWN OF LEXINGTON—BOARD OF PUBLIC WORKS
SEWER DIVISION

DATE _____


NO. _____

The undersigned applies for the construction of a particular sewer connecting No. 84 Baker Ave.
Street and hereby agrees to comply with the Rules and Regulations governing the construction and use of Particular
Sewers, as now or at any future time established by the Board of Selectmen.

Am't. of Estimate \$ 120.00

Am't. Paid \$ _____

_____ Owner

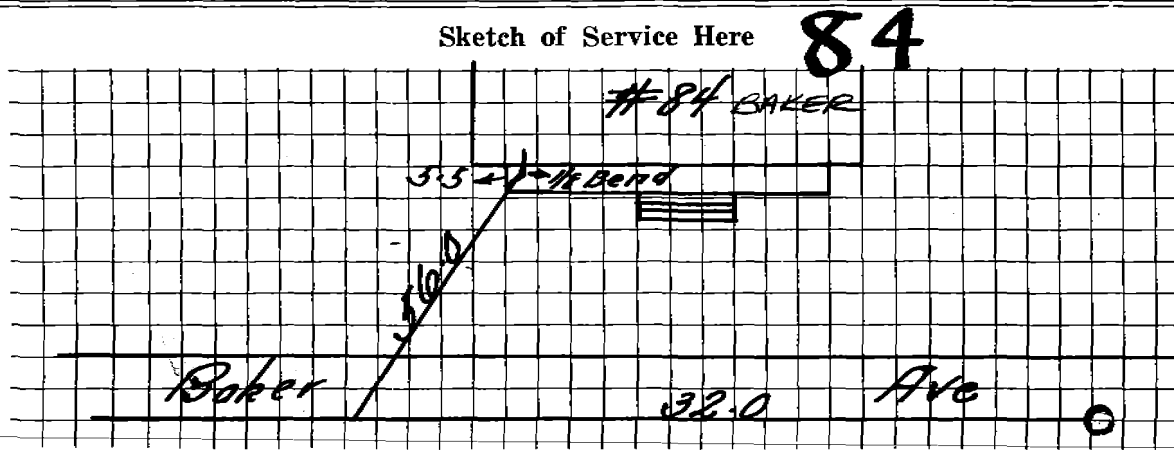

Connection made in _____ Street.

Work completed _____ 19

Remarks: