


DATE 9/30/21

TOWN OF LEXINGTON — BOARD OF PUBLIC WORKS

SEWER DIVISION

Sketch of Service Here

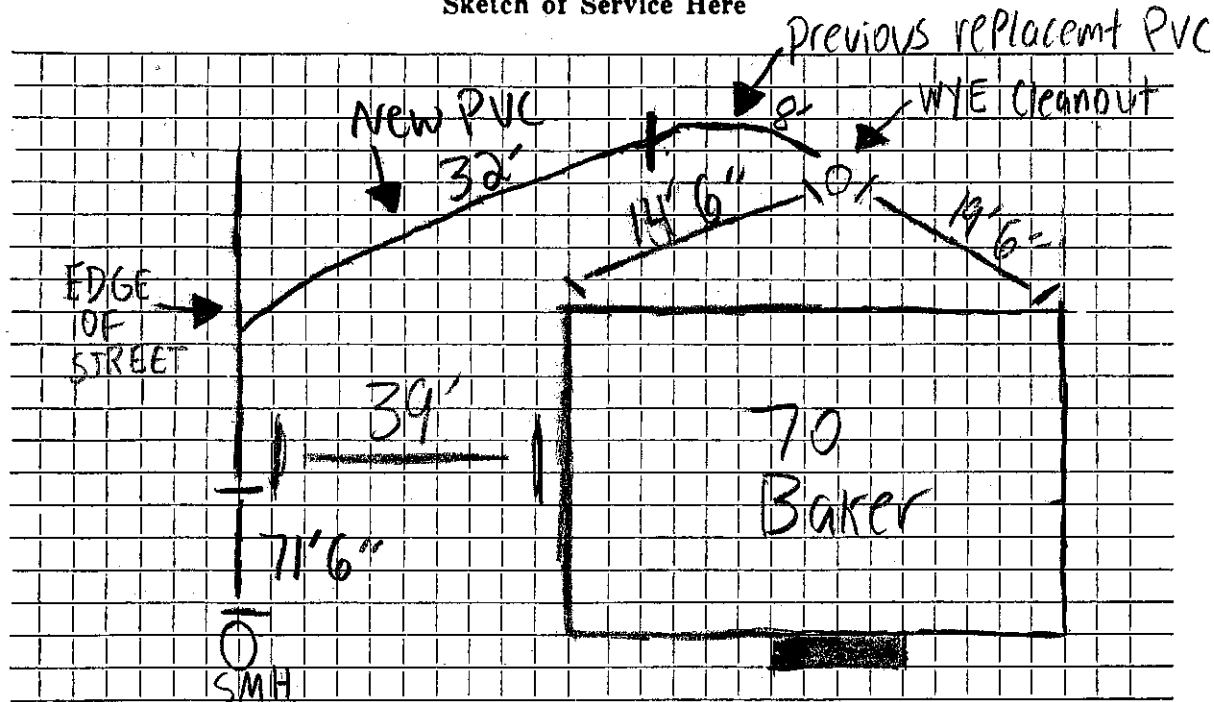

Connection made in 70 Baker St Street. Work completed

Remarks: INSTALLED By EYLAN CONSTRUCTION