

Name Herbert G. McConchie

Service No. 59

Address # 12 BALFOUR ST.

LOT 9

Location

Kind of Pipe

Size

Size of Main

~~Repair/ Renewal~~—New Service WO #7242

Location Comm 7-16-62


Date	Material	Amount	Total	Date	Amount
8-2-61	Labor	40.42		5-16-62	75.00
	10% O.H.	4.04	44.46	7-16-62	14.38
	21' 6" Transite pipe @.78		16.38	3-24-64	75.21
	1 6" 90° Transite Elbow		5.40		164.59
	2 Hrs. Town Shovel @6.50		13.00		
	2 Hrs. Trucking @3.00		6.00		
	1 Hr. Trojan Loader @3.00		3.00		
	BILL WHEN CONNECTED		88.24		
5/22/62	Labor	20.68			
	10% O.H.	2.07	22.75		
	62' 6" Transite Pipe @ .78		48.36		
	1 22½° Transite Elbow		2.24		
	1 Hr. Trucking @ 3.00		3.00		
			164.59		

DATE \_\_\_\_\_

TOWN OF LEXINGTON — BOARD OF PUBLIC WORKS

SEWER DIVISION

Sketch of Service Here **12**

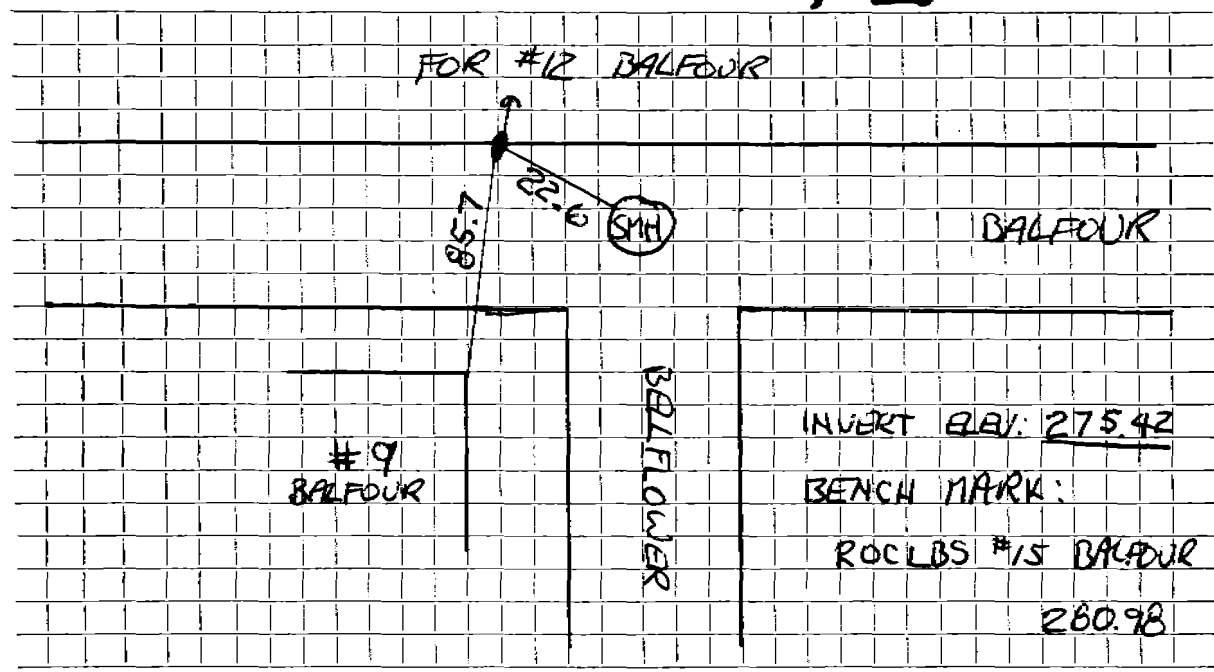

Connection made in ..... Street. Work completed .....

Remarks: .....  
.....  
.....