

Name Leo Chudigian

Service No. 49

Address # 15 BALFOUR ST. LOTS 494-497

Location

Kind of Pipe

Size

Size of Main

Repair—Renewal—New Service Valeri #1086


Location AUG 5 1968

Date	Material	Amount	Total	Date	Amount
8-1-61	Labor	40.42		6-24-68	<i>Deposit</i>
	10% O.H.	4.04	44.46		72 82
	12' 6" Transite pipe @.78		9.36		
	2 Hrs. Town Shovel @6.50		13.00		
	2 Hrs. Trucking @3.00		6.00		
	BILL WHEN CONNECTED		72.82		
7-10-68	53' 6" Transite pipe				
	5' 4" Cast Iron pipe				

DATE _____

TOWN OF LEXINGTON — BOARD OF PUBLIC WORKS

SEWER DIVISION

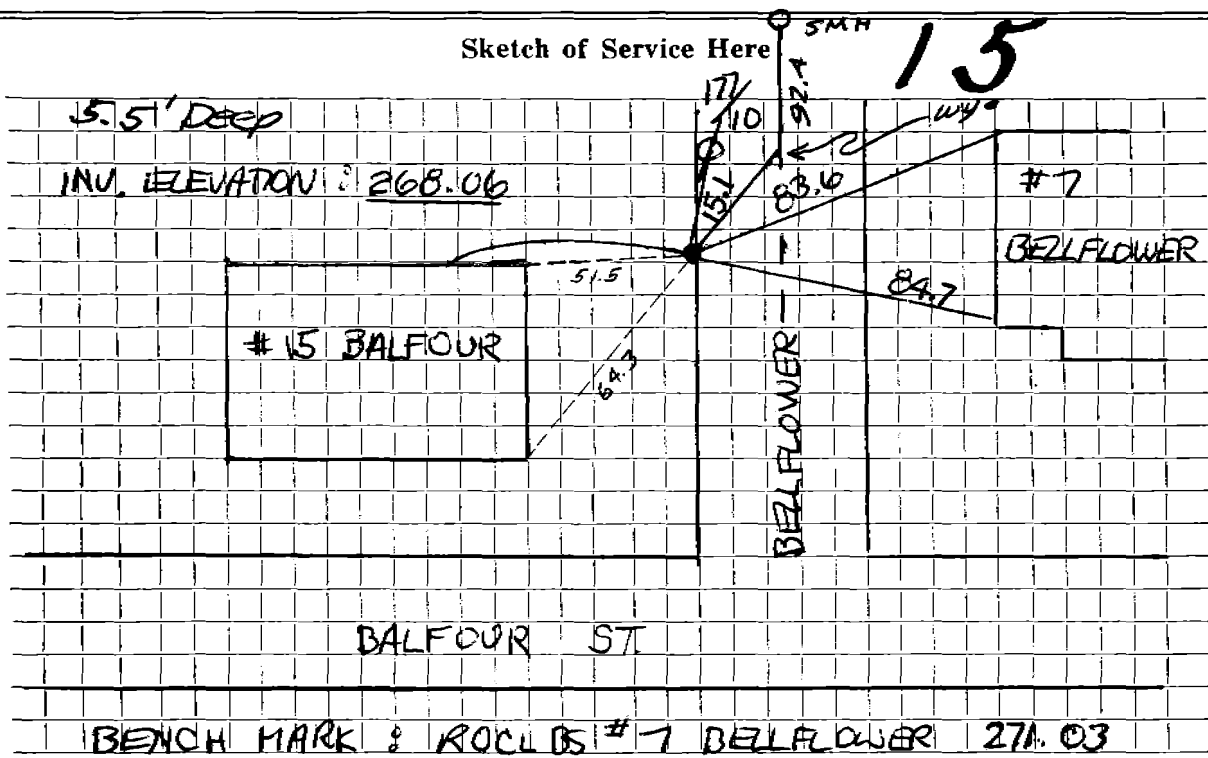

Connection made in Street. Work completed

Remarks:

.....

.....