

Name

Service No.

Address 16 Balfour St.

Location

Kind of Pipe

Size

Size of Main

Repair—Renewal—New Service

Location

Date

Material

Amount

Total

Date

Amount

7-18-59

38' 6" Transite

1 6" 1 1/4" Transite Elbow


1 6" 1 1/4" Transite Bend

DATE _____

TOWN OF LEXINGTON — BOARD OF PUBLIC WORKS
SEWER DIVISION

Sketch of Service Here

16 S.S. FOR #16

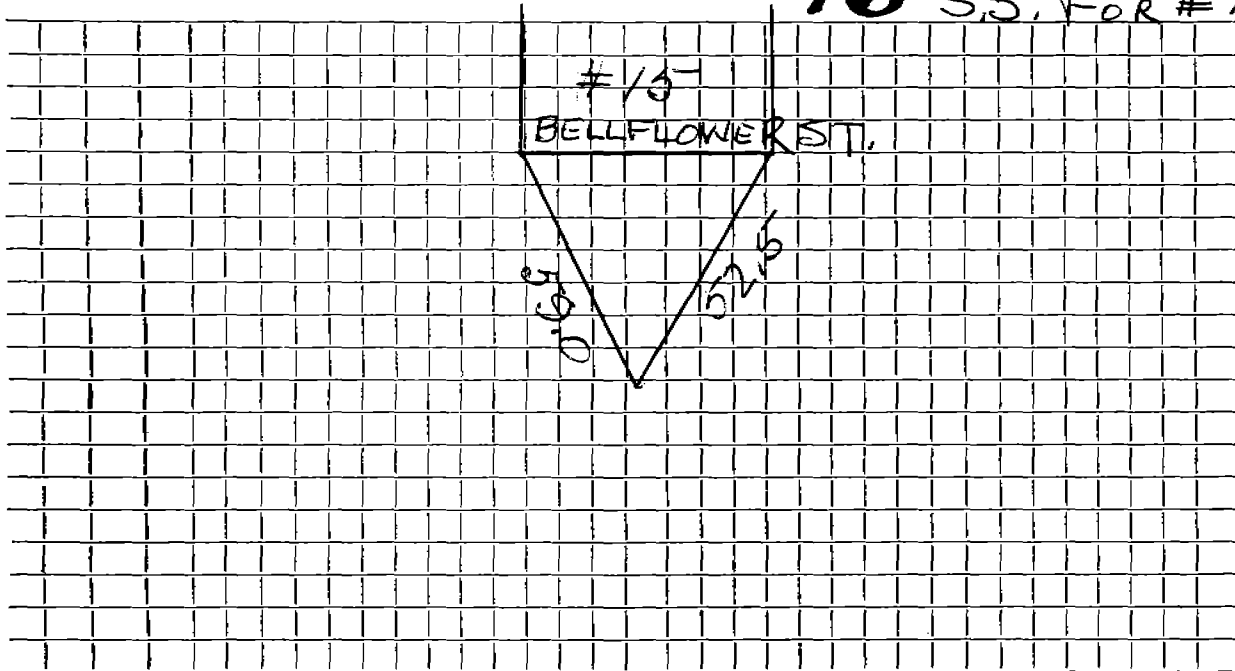

Connection made in Street. Work completed

Remarks:

.....

.....