

Name Chapin Harris

Service No. 63

Address 20 Belfour St.

Location

Kind of Pipe

Size

Size of Main

~~Repair or Renewal~~ — New Service

Location *Conn 7-5-60*

Date	Material	Amount	Total	Date	Amount
5-4-60	Labor 73.14			4-29-60	200 00
	10% O.H. 7.31		80 45	7-5-60	48 94
	1/4" 6" Transite Pipe @.78		36 66		151 06
	1 6" Transite 22 1/2° Bend		6 21		
	1 6" Transite 11 1/4° Elbow		2 24		
	3 Hrs. Town Shovel @ 6.50		19 50		
	2 Hrs. Trucking @ 3.00		6 00		
			151 06		


DATE _____

TOWN OF LEXINGTON — BOARD OF PUBLIC WORKS

SEWER DIVISION

Sketch of Service Here

20

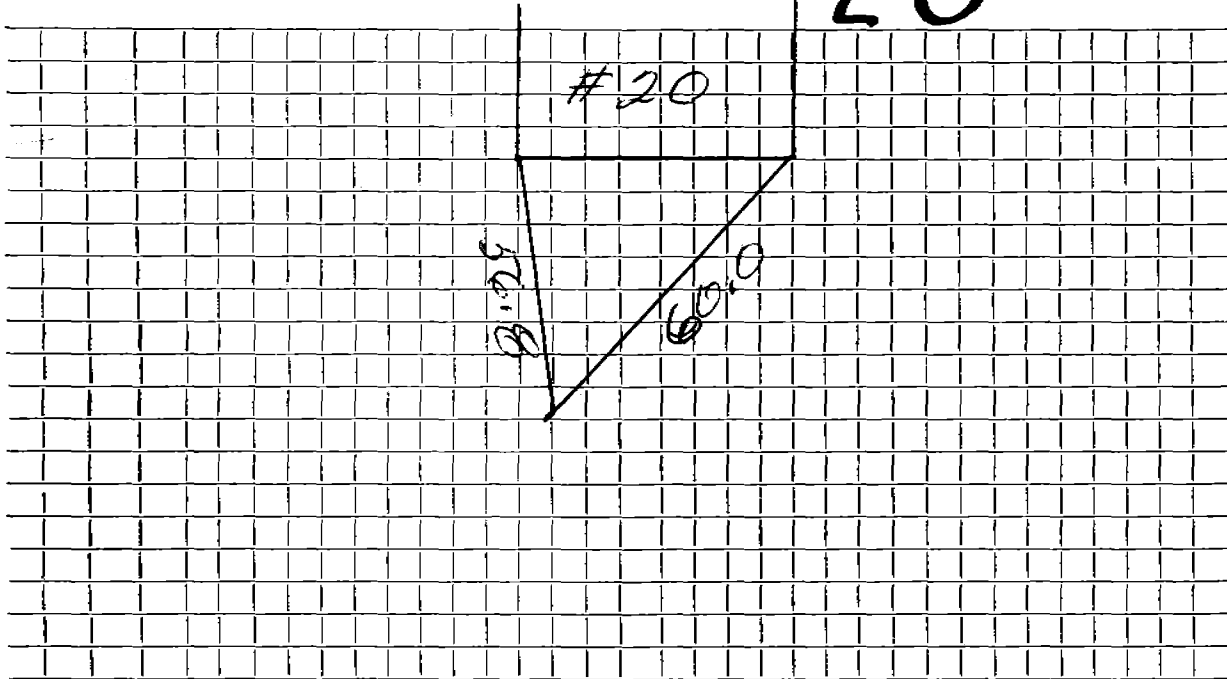

20

3.0

6.0

Connection made in Street. Work completed

Remarks :
.....
.....