

Name Arthur D. Ritchie Jr.

Service No. 84

Address # 21 BALFOUR ST LOTS 1

Location

Kind of Pipe

Size

Size of Main

~~Repair~~ ~~Renewal~~ ~~—~~ New Service Eagle #1192


Location JAN 27 1969

Date	Material	Amount	Total	Date	Amount
8-2-61	Labor	35.85		9-13-68	69.36
	10# O.H.	3.59	39.44	Deposit	
	14' 6" Transite pipe @.78		10.92		
	2 hrs. Town Shovel @6.50		13.00		
	2 hrs. Trucking @3.00		6.00		
	BILL WHEN CONNECTED		69.36		
9-17-68	55' 6" Transite pipe				
	10' 4" Cast Iron pipe				

DATE _____

TOWN OF LEXINGTON — BOARD OF PUBLIC WORKS
SEWER DIVISION

Sketch of Service Here **21**

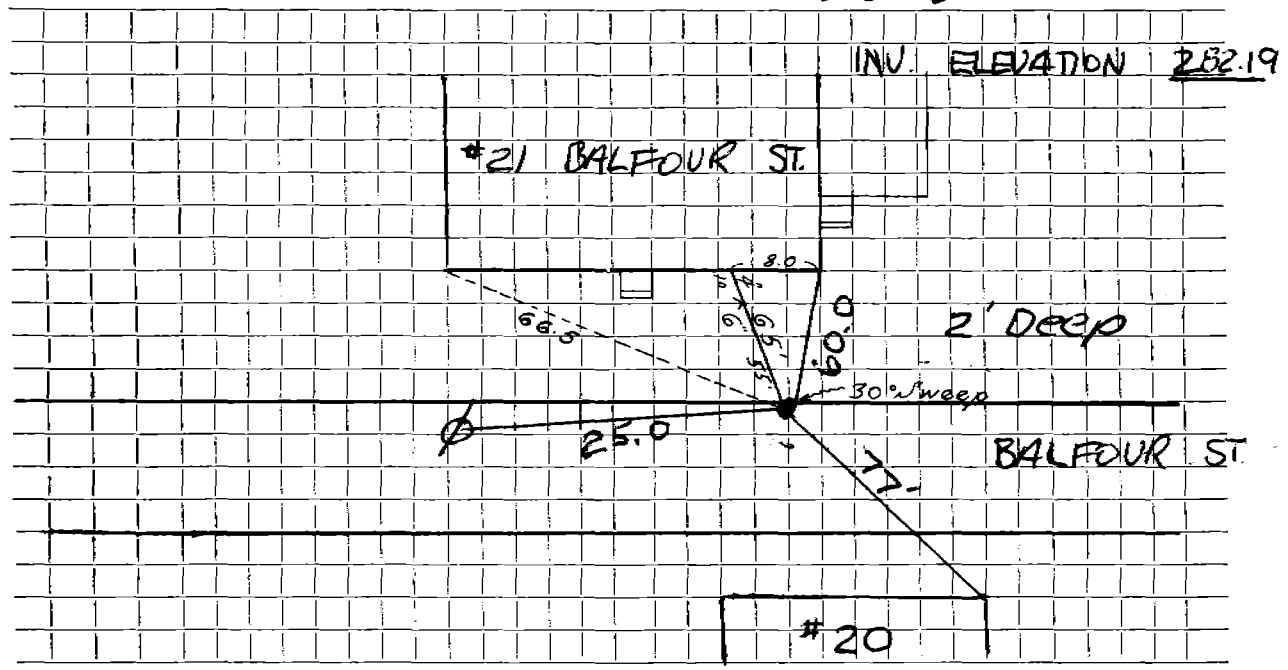

Connection made in Street. Work completed

Remarks:
.....
.....