

Name Robert F. Farwell

Service No. 101

Address 24 Balfour Street

Location

Kind of Pipe

Size

Size of Main

~~Repair - Renewal~~ New Service


Location *Comm 8-1-60*

Date	Material	Amount	Total	Date	Amount
6-21-60	Labor	79 73		6-10-60	200 00
6-22-60	Labor	76 16		9-23-60	126 50
		155 89			326 50
	10% O.V.	15 58	171 47		
72'	6" Transite pipe		56 16		
30	Sticks Dynamite #26		7 80		
14	Blasting Caps #28		3 92		
1	22 1/2" Transite Bend		6 21		
12	Hrs pippin Shovel @4.50		54 00		
6	Hrs Trucking @3.00		18 00		
3	Hrs Compressor @3.00		9 00		
			326 56		
	(Ledge)				

DATE _____

TOWN OF LEXINGTON — BOARD OF PUBLIC WORKS
SEWER DIVISION

Sketch of Service Here **24** S.S. For #24

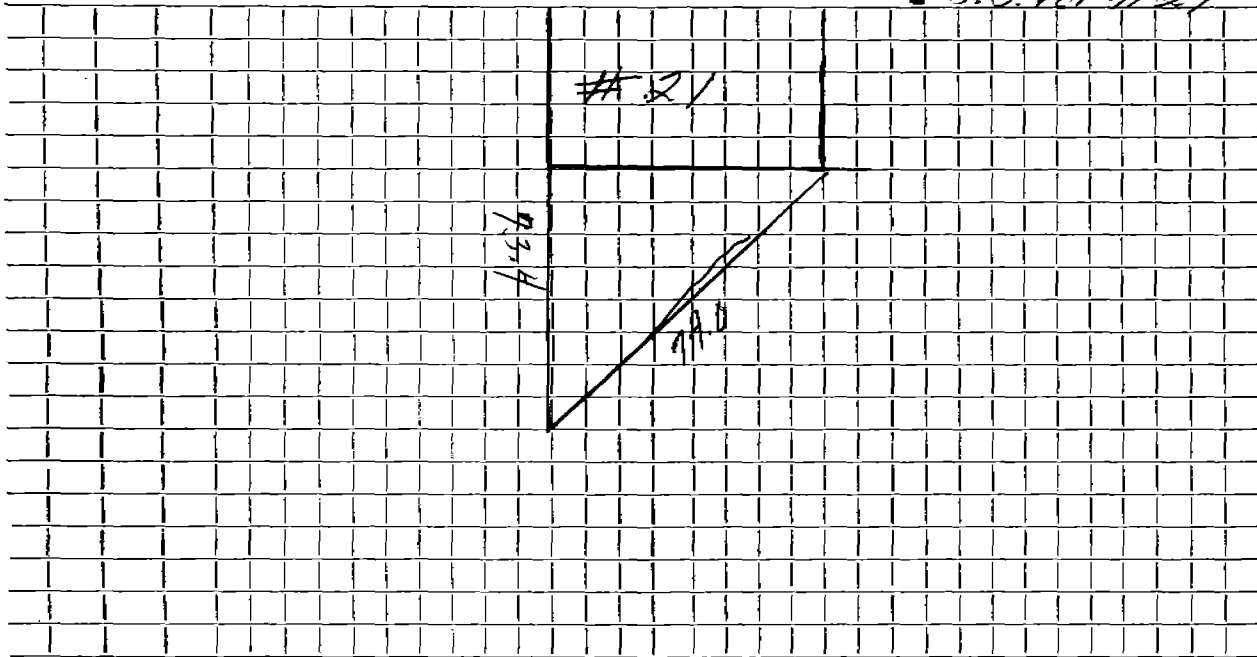

Connection made in Street. Work completed

Remarks:
.....
.....