

Name John Grant

Service No. 13

Address 25 Balfour Street

Location

Kind of Pipe John Grant Permit #A187

Size

Size of Main

~~Repair~~ ~~Renewal~~ - New Service


Location MAY 2 1966

Date	Material	Amount	Total	Date	Amount
9-29-61	Labor	8.44		3-15-66	45.46
	10% O.H.	.84	9.28	<i>Deposit</i>	
26	6" Transite pipe @ .78		20.28		
1	6" 90° Transite Elbow		5.40		
1	6" End Cap		2.50		
1	hr. Trucking @ 3.00		3.00		
1	hr. pippin @ 5.00		5.00		
	(BILL WHEN CONNECTED)		45.46		
3-21-66	37' 6" Transite pipe				

DATE _____

TOWN OF LEXINGTON — BOARD OF PUBLIC WORKS
SEWER DIVISION

Sketch of Service Here **25**

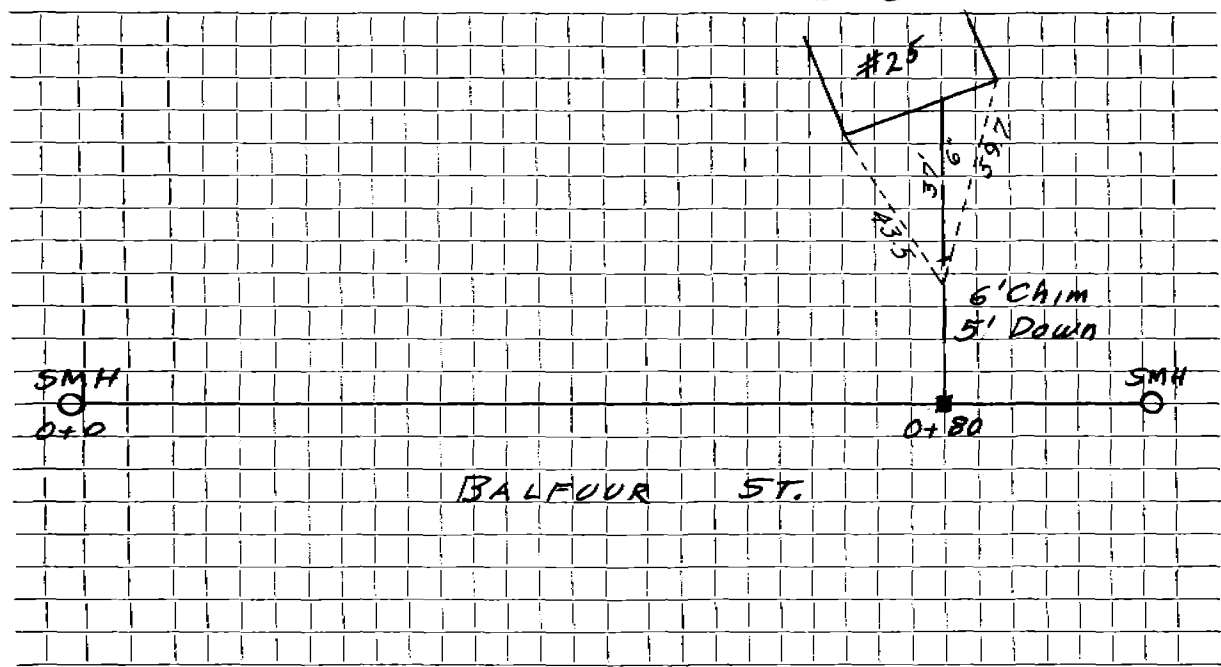

Connection made in Street. Work completed

Remarks:
.....
.....