

Name

Service No. ^{Permit} 4859

Address 28 Balfour ST

Location

Kind of Pipe

Size

Size of Main

Repair—Renewal—New Service J. McLaughlin

Location 1st 2 1/2 B/Pg 5B


Date	Material	Amount	Total	Date	Amount
8/10/61	EXISTING (ST) 14" - 6" - A.C.				
	1 90° Elbow				
	1 1 1/4" bend				
2012 9/4	4"				
	1 4x6				
	1 6" Clean out				
	52.5 6" PVC				
	6" PVC X A.S. Fernco 5 1/2" clean				

DATE _____

TOWN OF LEXINGTON — BOARD OF PUBLIC WORKS

SEWER DIVISION

Sketch of Service Here

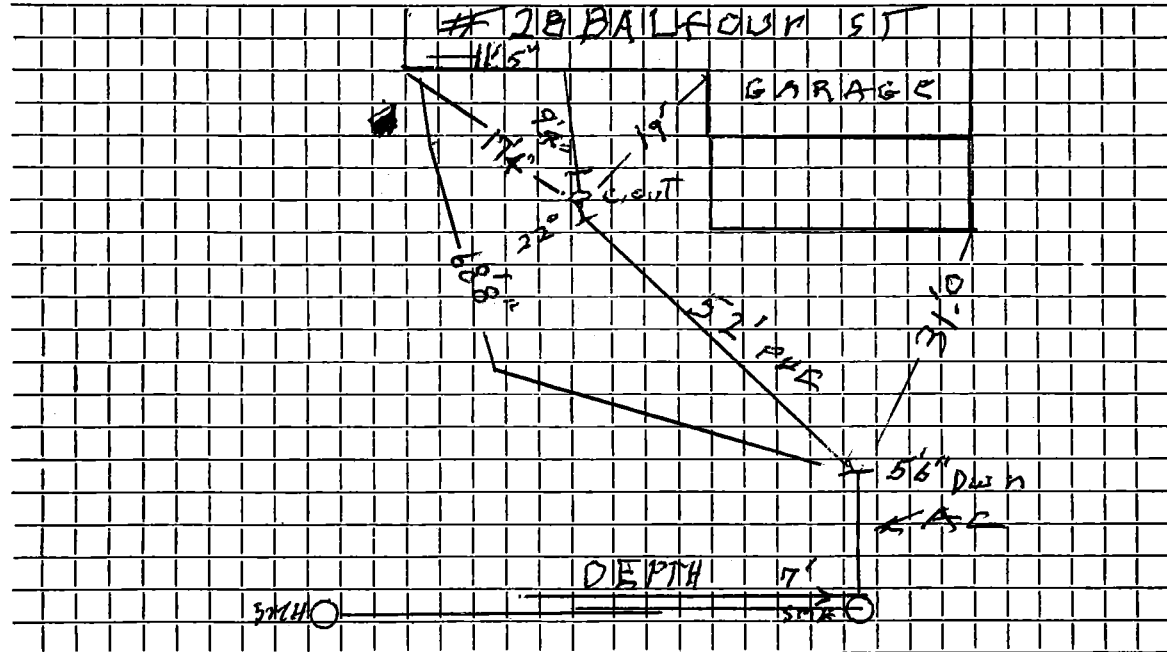

Connection made in 1961 - To house 2017. Street.

Work completed M.C. Rughlin, J.R.W.

Remarks: No info.

.....
.....