

Name

Service No.

Address # 30 BALFOUR ST. LOTS 268-471

Location

Kind of Pipe

Size

Size of Main

~~Repair~~—Renewal—New Service

Location

Date	Material	Amount	Total	Date	Amount
------	----------	--------	-------	------	--------


8-10-61	Labor	27 02			
	10 % O.H.	2 70	29 72		
	13' 6" Transite Pipe @.78		10 14		
	1 11 1/2" Transite Band		2 24		
	1 Hr. Town Shovel @ 6.50		6 50		
	1 Hr. Trucking @ 3.00		3 00		
	BILL WHEN CONNECTED		51 60		

DATE _____

TOWN OF LEXINGTON — BOARD OF PUBLIC WORKS

SEWER DIVISION

Sketch of Service Here **30**

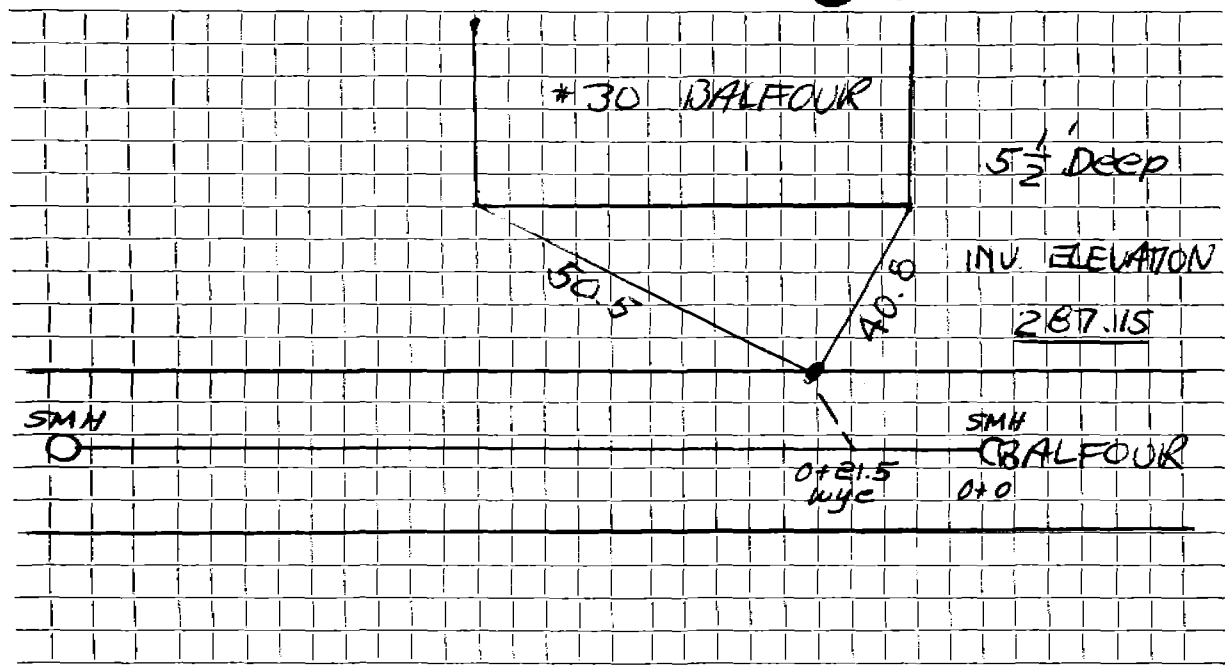

Connection made in Street. Work completed

Remarks:
.....
.....