

Name

Service No.

Address

* 33 BALFOUR ST LOTS 476-477

Location

Kind of Pipe

Size

Size of Main

~~Repair~~ ~~Renewal~~ — New Service


Location

Date	Material	Amount	Total	Date	Amount
8-9-61	Labor	39 23			
	10% O.H.	3 92	43 15		
13	6" Transite Pipe @.78		10 14		
1	11 1/4" Transite Elbow		2 24		
2	Hrs. Town Shovel @ 6.50		13 00		
2	Hrs. Trucking @3.00		6 00		
1	Hr. Trailer @3.00		3 00		
	BILL WHEN CONNECTED		77 53		

DATE _____

TOWN OF LEXINGTON — BOARD OF PUBLIC WORKS
SEWER DIVISION

Sketch of Service Here **33**

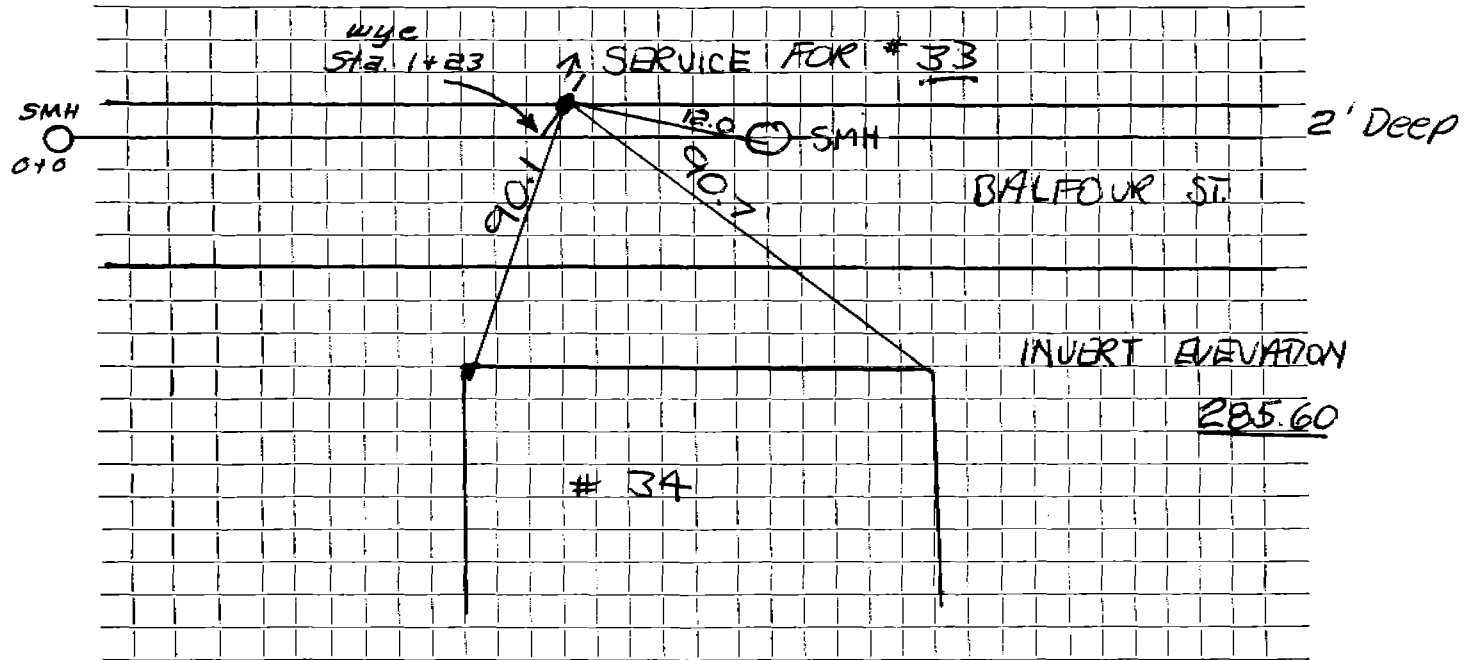

Connection made in Street. Work completed

Remarks:
.....
.....