

Name Benjamine Golini

Service No. 18

Address 35 Balfour Street

Lots 527-528

Location

Kind of Pipe

Size

Size of Main

~~Repair~~ ~~Renewal~~ ~~New Service~~

Valeri Const. #2619

Location AUG 16 1976

Date	Material	Amount	Total	Date	Amount
8-3-60	Labor	37 52		4-1-75	Deposit
	10% OH	3 75	41 27		80.55
	25' 6" Transite pipe @78		19 50		
	1 6" Clay elbow		1 88		
	1 6" Duplex adapter		1 90		
	2 Hrs. Town shovel @6.50		13 00		
	1 Hr. Trucking @3.00		3 00		
	BILL WHEN CONNECTED		80 55		
4/7/75	40' 6" Transite Pipe				
	20' 4" Cast Iron Pipe				


DATE _____

TOWN OF LEXINGTON — BOARD OF PUBLIC WORKS
SEWER DIVISION

35

Sketch of Service Here

Ties For #35 BGLFOUR

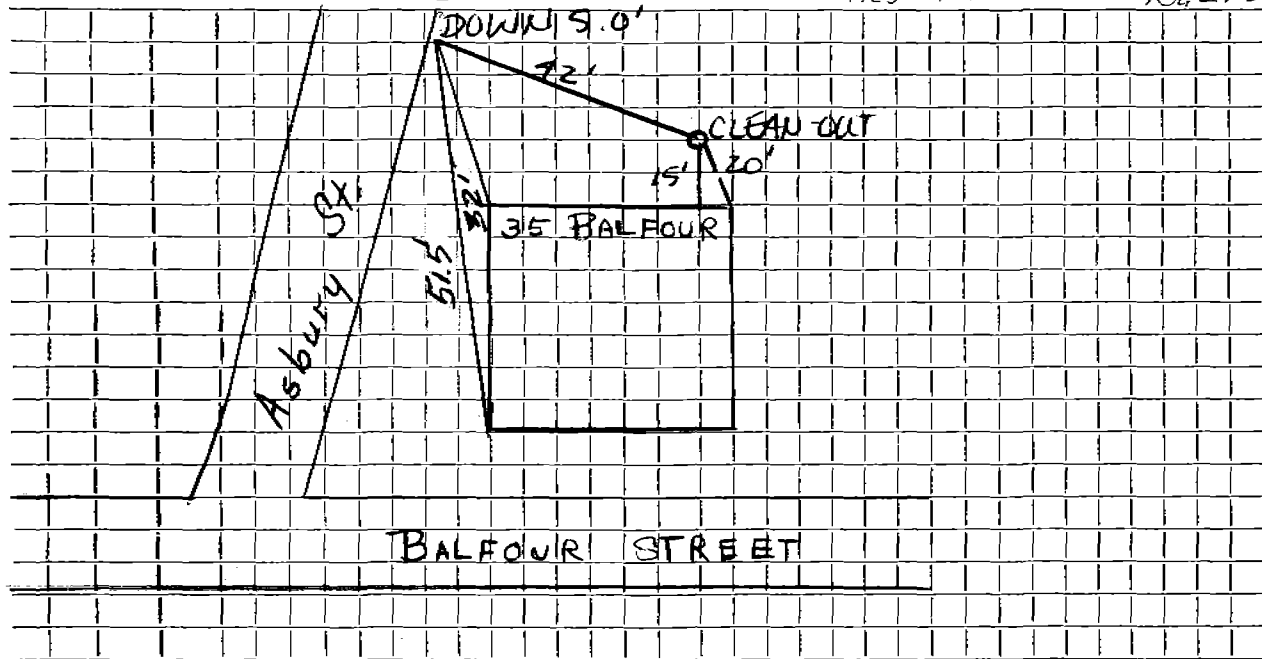

Connection made in 35 BALFOUR Asbury street. Work completed 4/7/75

Remarks:

.....

.....