




DATE May 1983

TOWN OF LEXINGTON — BOARD OF PUBLIC WORKS  
SEWER DIVISION

Sketch of Service Here **44**

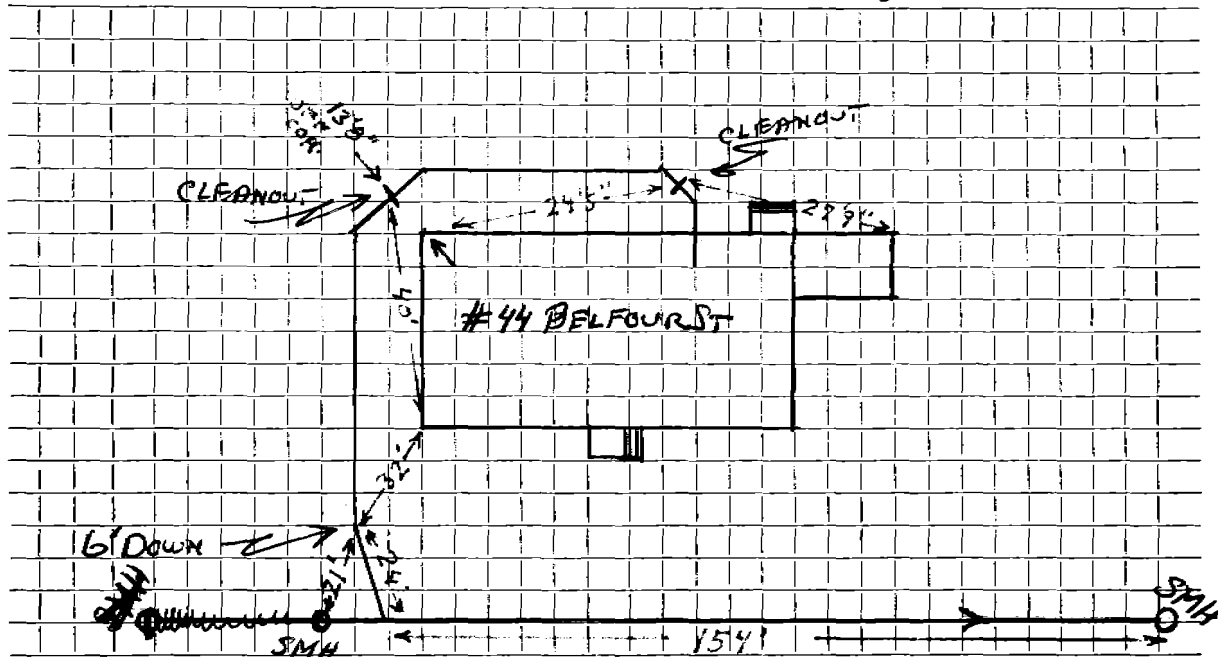

Connection made in BALFOUR ST Street. Work completed July 3, 1985

Remarks: .....