

Name

Service No.

Address

48 Balfour

Location

Kind of Pipe

6" PVC

Size

Size of Main

8" PVC

Repair—Renewal—New Service


Location

Date	Material	Amount	Total	Date		Amount
6.3.99	Inside installed			5.83	24.' 6" PVC	
	8' -4" PVC					
	33' -6" PVC					
	2-6" 22° Bends					
	1-4"x6" PVC to PVC FRENCH					

DATE \_\_\_\_\_

TOWN OF LEXINGTON — BOARD OF PUBLIC WORKS  
SEWER DIVISION

Sketch of Service Here

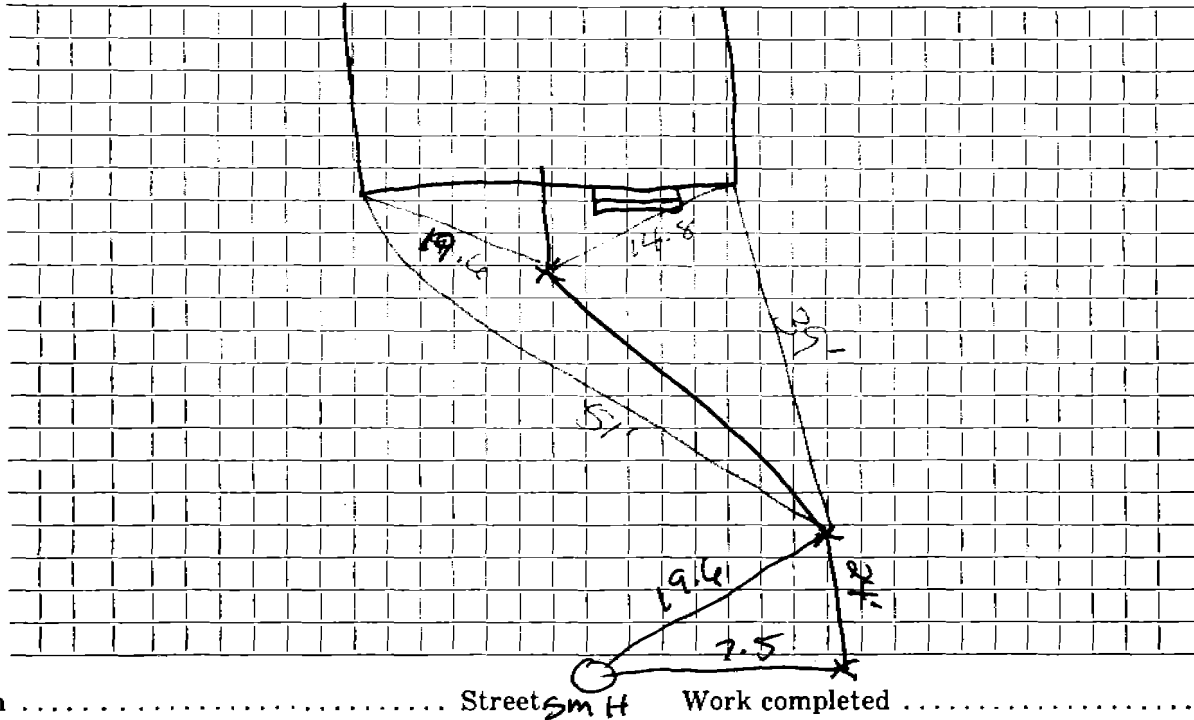

Connection made in ..... Street 5m H Work completed .....

Remarks: .....

.....

.....