


DATE OCT 23 1997

TOWN OF LEXINGTON — BOARD OF PUBLIC WORKS
SEWER DIVISION

Sketch of Service Here

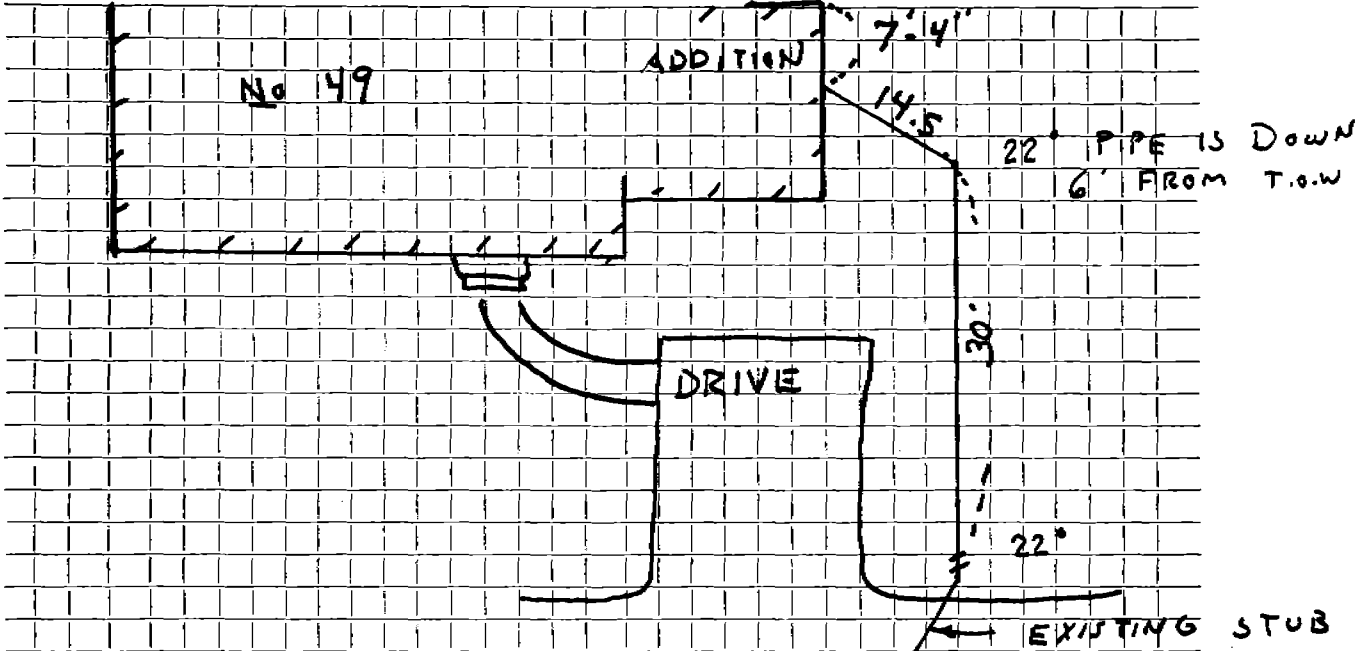

Connection made in BALFOUR ST. Street.

Work completed A. CARDILLO INC.

Remarks:


.....

.....

DATE _____

TOWN OF LEXINGTON — BOARD OF PUBLIC WORKS
SEWER DIVISION

Sketch of Service Here **49**

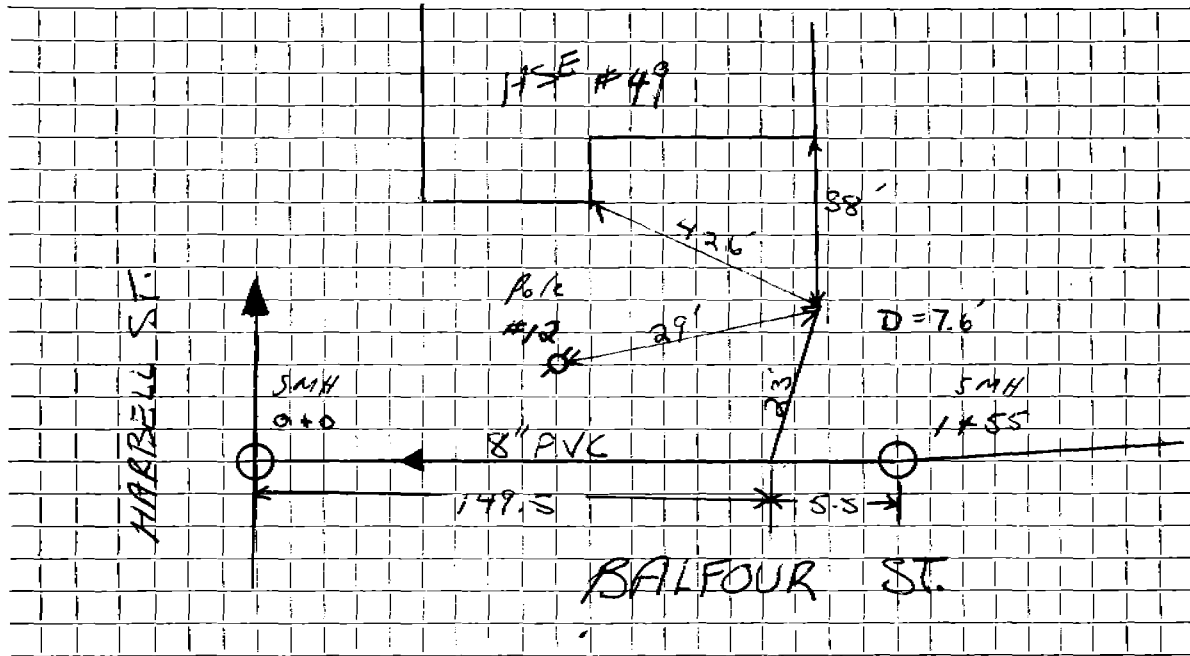

Connection made in Balfour Street. Work completed

Remarks:
.....
.....