

Name Leonard W. Jackson

Service No. 184

Address # 5 BALFOUR ST. LOTS C

Location

Work order #8311

Kind of Pipe

Size

Size of Main

Repair-Renewal-New Service

100# 8311

Location


MAR 23 1964

Date	Material	Amount	Total	Date	Amount
8-1-61	Labor	38.00		11-14-63	200.00
	10% O.H.	3.80	41.80	4-10-64	83.58
	16' 6" Transite pipe @ 3.78		12.48		283.58
	2 hrs. Town Shovel @ 6.50		13.00		
	2 hrs. Trucking @ 3.00		6.00		
	BILL WHEN CONNECTED		73.28		
11/19/63	Labor	78.01			
11/20/63	"	27.78			
		105.79			
	10% O. H.	10.58	116.37		
	37' 6" Transite pipe @ .82		30.34		
	1 22 $\frac{1}{2}$ " Transite Bend		4.09		
	6 yds. Loam @ 3.00		18.00	4/22/73	Solids
	5 hrs. Town shovel @ 6.50		32.50	5-31-74	Solids
	3 hrs. Trucking @ 3.00		9.00		
			283.58		

DATE _____

TOWN OF LEXINGTON — BOARD OF PUBLIC WORKS
SEWER DIVISION

Sketch of Service Here **5**

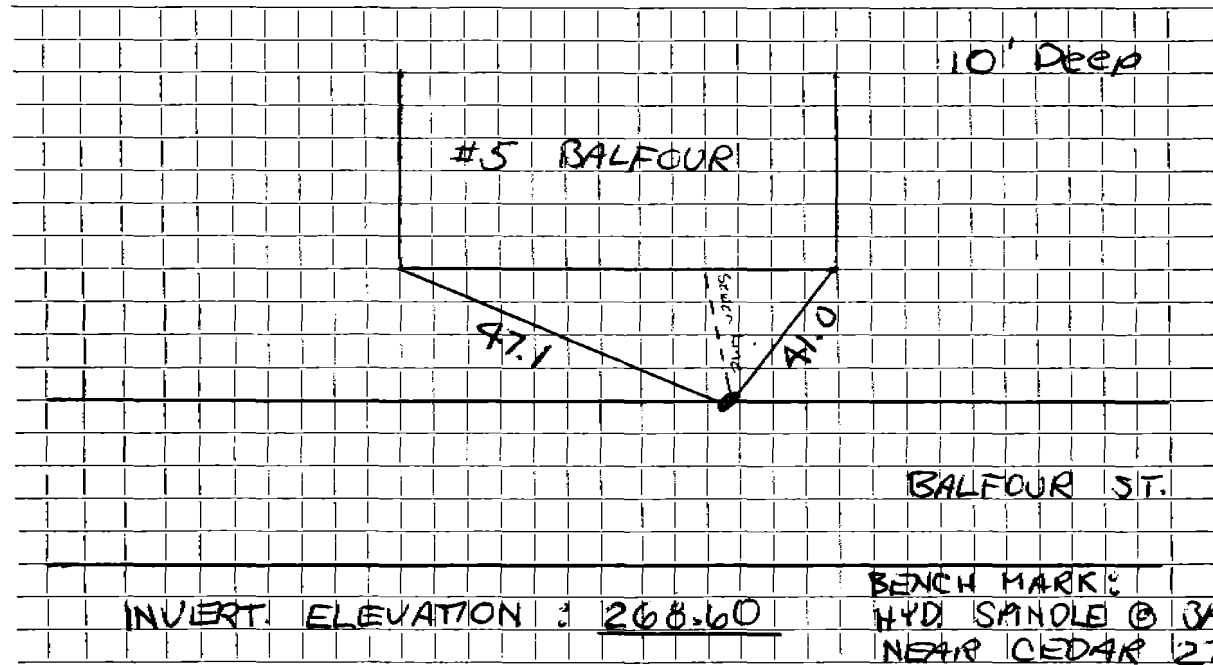

Connection made in Street. Work completed

Remarks: ...16'... Deep... brought off... to... side of... Road.....