

Name

Service No.

Address

55 BALFOUR ST.

Location

Kind of Pipe

Size

Size of Main

Repair—Renewal—New Service

Location

Date

Material

Amount

Total


Date

Amount

DATE 10/8/59

TOWN OF LEXINGTON — BOARD OF PUBLIC WORKS
SEWER DIVISION

Sketch of Service Here **55**

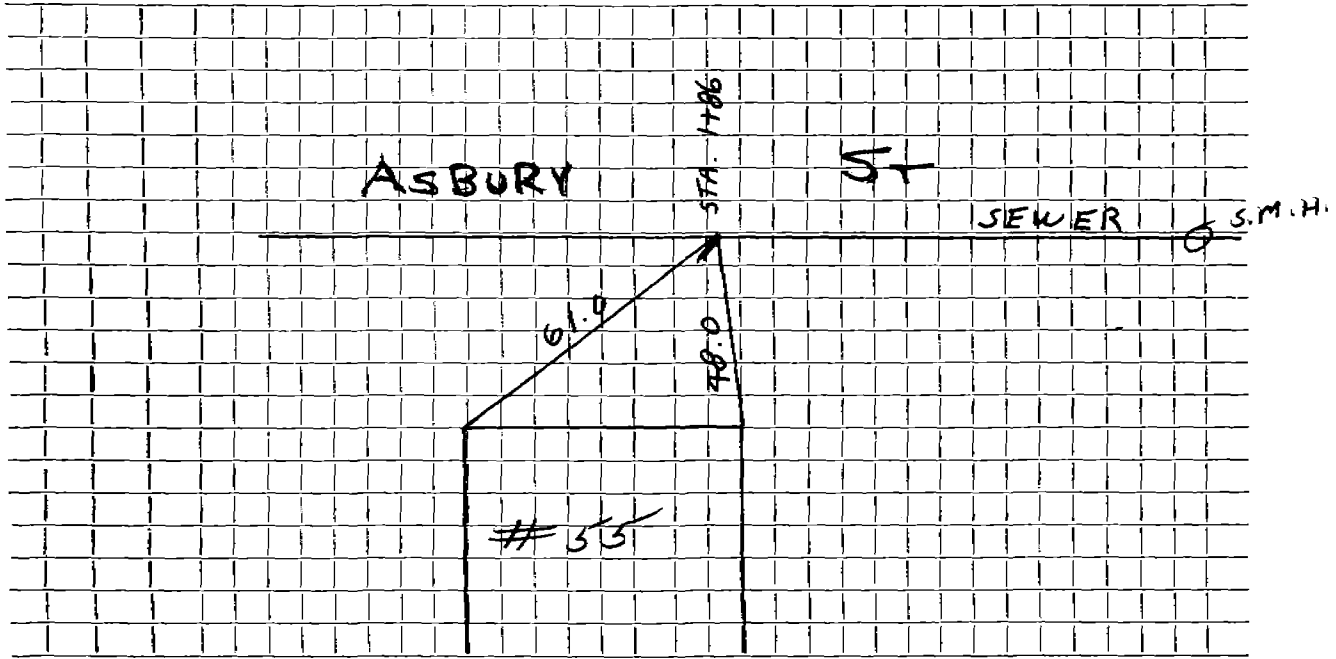

Connection made in ... ASBURY Street. Work completed

Remarks:
.....
.....