

DATE _____


TOWN OF LEXINGTON — BOARD OF PUBLIC WORKS

SEWER DIVISION

8

Sketch of Service Here

S.S. FOR # 8

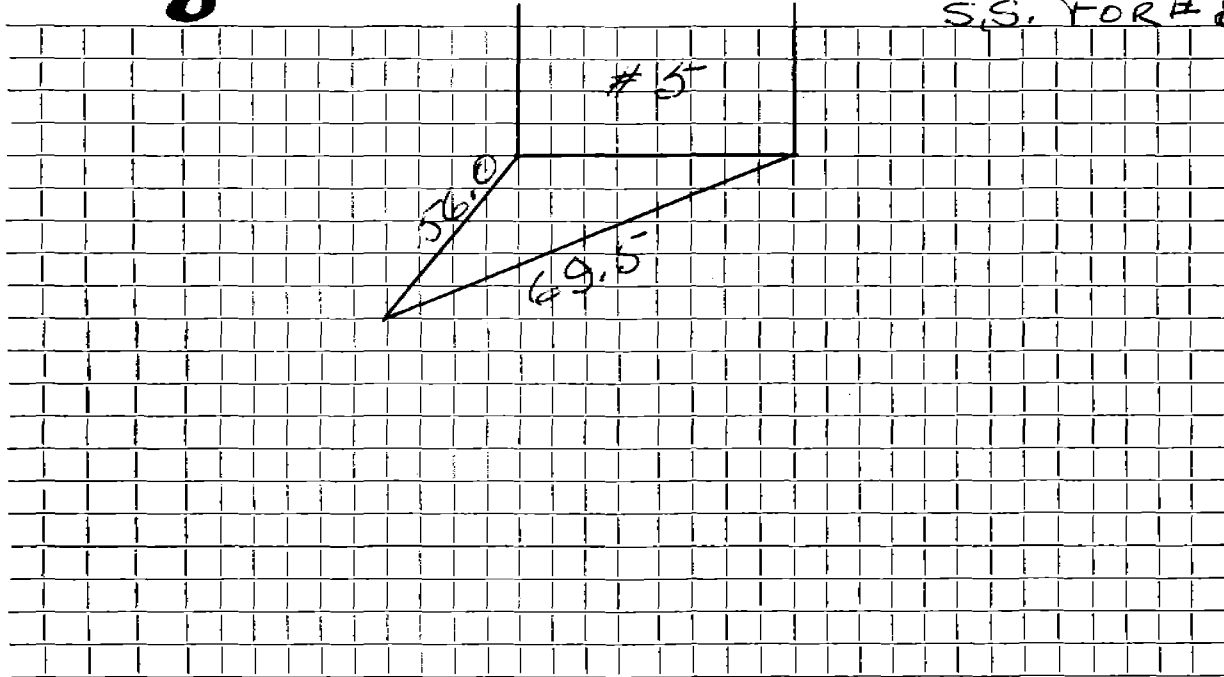

Connection made in Street. Work completed

Remarks:
.....
.....