

Name A.W. Williams

Service No. 47

Address 9 Balfour Street

Location

Kind of Pipe

Size

Size of Main

~~Repair~~ ~~Renewal~~ ~~New Service~~

Location Comm 7-5-60


Date	Material	Amount	Total	Date	Amount
4-28-60	Labor	65 95		4-22-60	250 00
4-29-60	"	7 61		7-5-60	93 93
		<u>73.56</u>			166 27
	10% O.H.	<u>7 36</u>	80 92		
	62' 6" Transite pipe @78		48 36		
	1 6" Transite Elbow		5 29		
	5 Hrs pippin shovel @4.50		22 50		
	3 Hrs Trucking @3.00		9 00		
			<u>166 07</u>		

DATE \_\_\_\_\_

TOWN OF LEXINGTON — BOARD OF PUBLIC WORKS

SEWER DIVISION

Sketch of Service Here

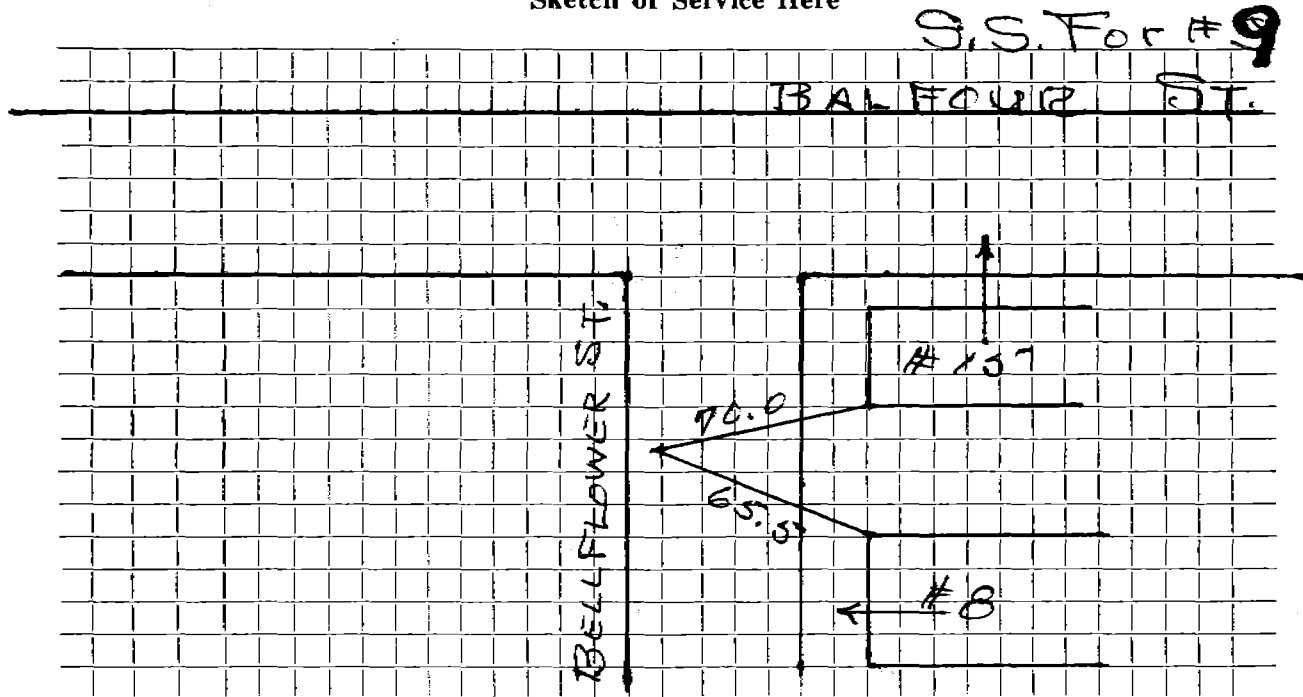

Connection made in ..... Street. Work completed .....

Remarks: .....

.....

.....