

Name

Service No.

Address

15 BALLARD TERR

Location

Kind of Pipe

Size

Size of Main

Repair Renewal New Service

Location

Date

Material

Amount

Total

Date

Amount

JUNE 99 5'6" 4" PVC

40 6" PVC

1 4X6 FENCE

1 6" PVC X CLAY FENCE

1 CLEAN OUT

11/16/54


12' 6" SEWER PIPE - CLAY

DATE _____

TOWN OF LEXINGTON — BOARD OF PUBLIC WORKS

SEWER DIVISION

Sketch of Service Here

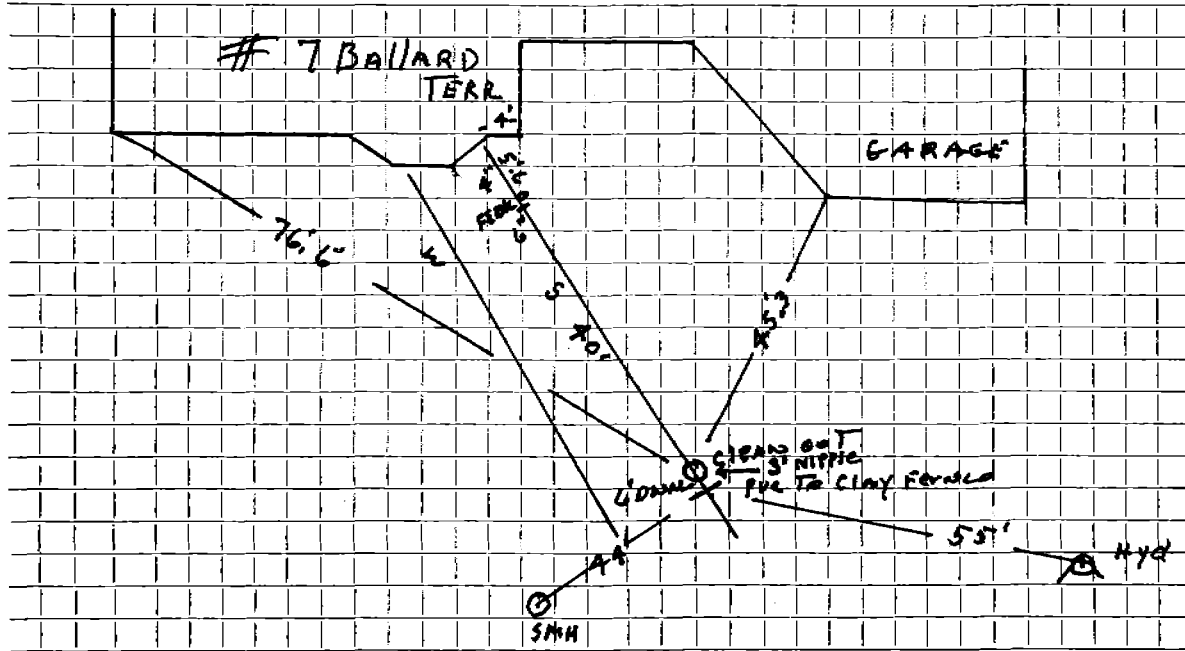

Connection made in Street. Work completed

Remarks:

.....

.....