


DATE 11/8/16

TOWN OF LEXINGTON — BOARD OF PUBLIC WORKS
SEWER DIVISION

Sketch of Service Here

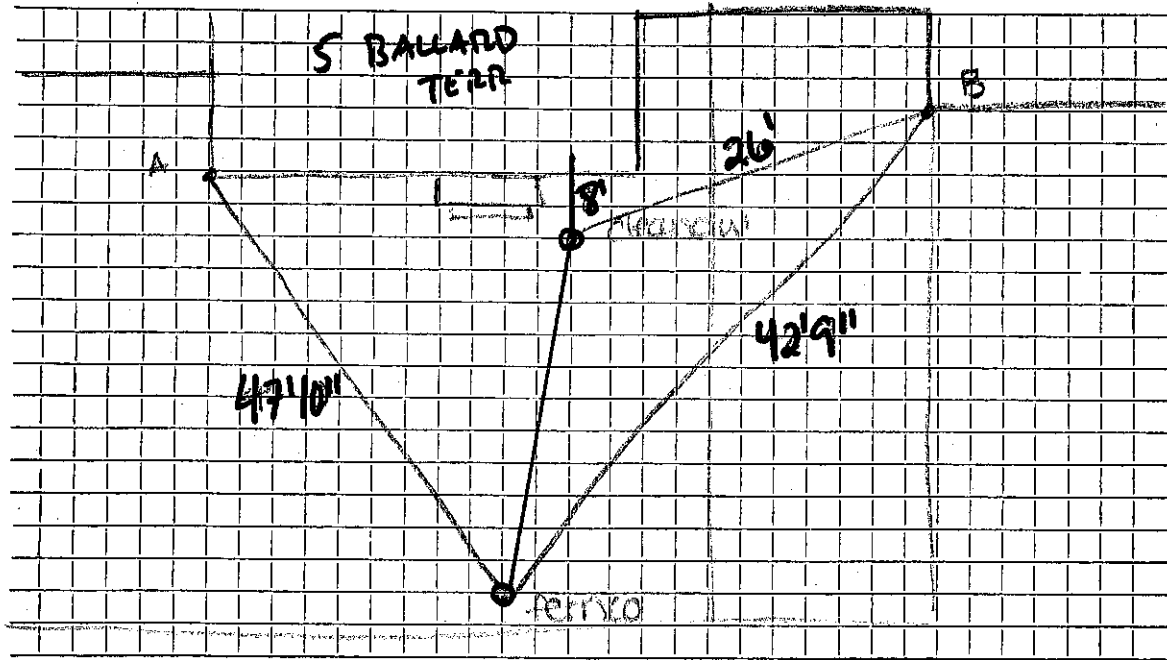

Connection made in Ballard Street. Work completed

Remarks:
.....
.....