Name	ame Service No.								
Address	7 Ballard Ter	race							
Location									
Kind of Pipe			Size		Size of Main				
Repail X	Rénéval-New Service				Location				
Date	Material	Amount.	Total	Date		Amount			
Dec. 1953	55' - INSTALLE	D BY DEVELOPER							
	· · · · · · · · · · · · · · · · · · ·								
	Labor								
HP-7919			1	1 1					

Name

Service No.


TOWN OF LEXINGTON—DEPT. OF PUBLIC WORKS SEWER DIVISION

DATE		NO

Am't of estimate \$....

Am't Paid \$.....

..... Owner

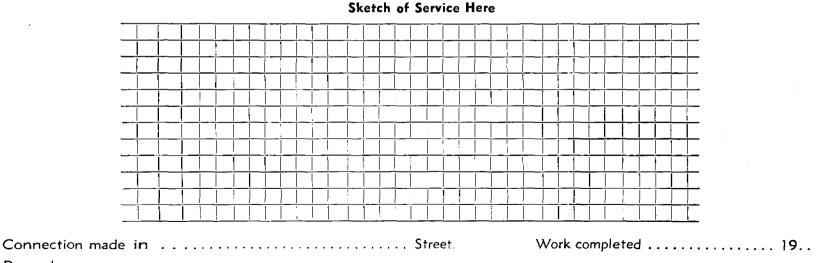

Remarks: