


DATE _____

TOWN OF LEXINGTON — BOARD OF PUBLIC WORKS
SEWER DIVISION

Sketch of Service Here

Lot L.C. 2

10

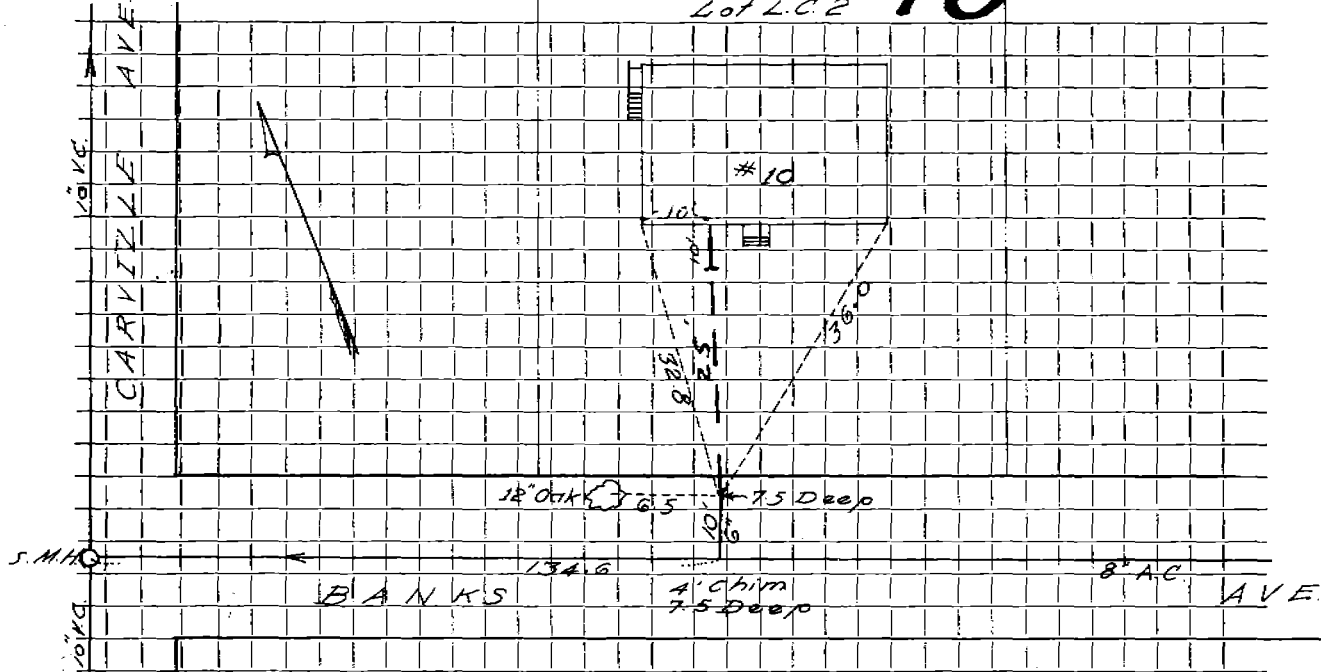

Connection made in #10 Banks Ave. Street. Work completed 4/17/74

Remarks:

.....

.....