

Name Joseph Potzka

Service No. 123

Address 14 Banks Avenue

Location Lots 448, 449, 450 & 451

Kind of Pipe

Size

Size of Main

Repair—Renewal—New Service Lexington Sewerage #1977

Location JUN 5 1972


Date	Material	Amount	Total	Date	Amount
1971-12-3-71	20' 6" Transite pipe @7.50	150.00			150.00
12-8-71	30' 6" Transite pipe				
	34' 4" Cast Iron pipe				

DATE \_\_\_\_\_

TOWN OF LEXINGTON — BOARD OF PUBLIC WORKS

SEWER DIVISION

Sketch of Service Here **14**

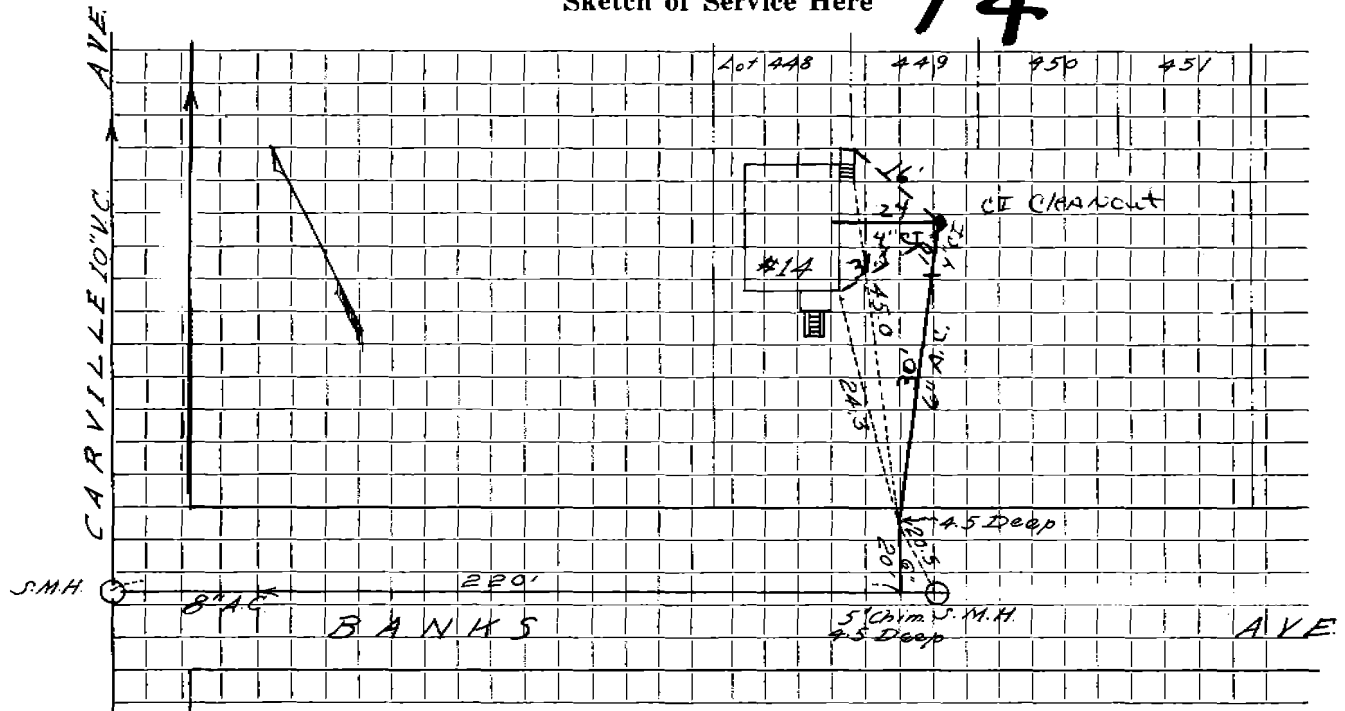

Connection made in ..... Street. Work completed .....

Remarks: .....  
.....  
.....