

Name *Harold Johnson*

Service No.

Address *17 BANKS AVE.*

Location

Kind of Pipe

Size

Size of Main

~~Repair~~ ~~Renewal~~ ~~New Service~~ *Rel-Scott #3062*

Location


Date	Material	Amount	Total	Date	Amount
------	----------	--------	-------	------	--------

<i>4-26</i>	<i>78</i>	<i>9'-6" ACP; 10'-4" CI</i>			
		<i>Easement</i>	<i>No Charge</i>		

DATE \_\_\_\_\_

TOWN OF LEXINGTON — BOARD OF PUBLIC WORKS  
SEWER DIVISION

Sketch of Service Here **17**

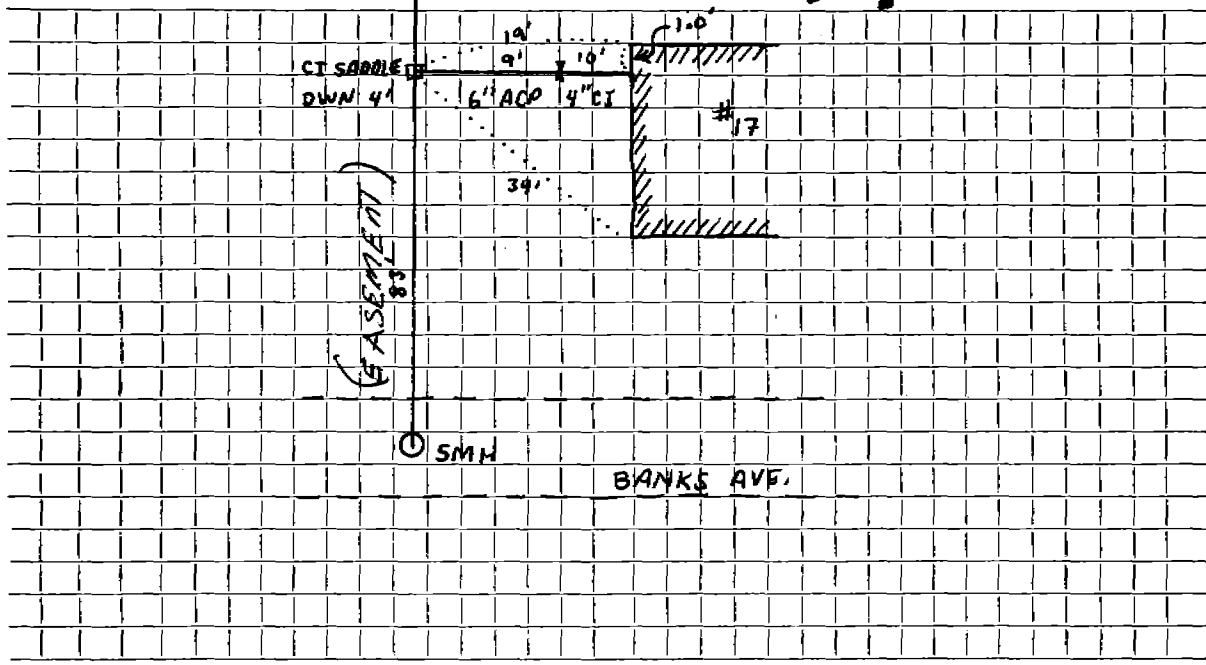

Connection made in EASEMENT Street. Work completed .....

Remarks: .....  
.....  
.....