




DATE \_\_\_\_\_

TOWN OF LEXINGTON — BOARD OF PUBLIC WORKS  
SEWER DIVISION

Sketch of Service Here **20**

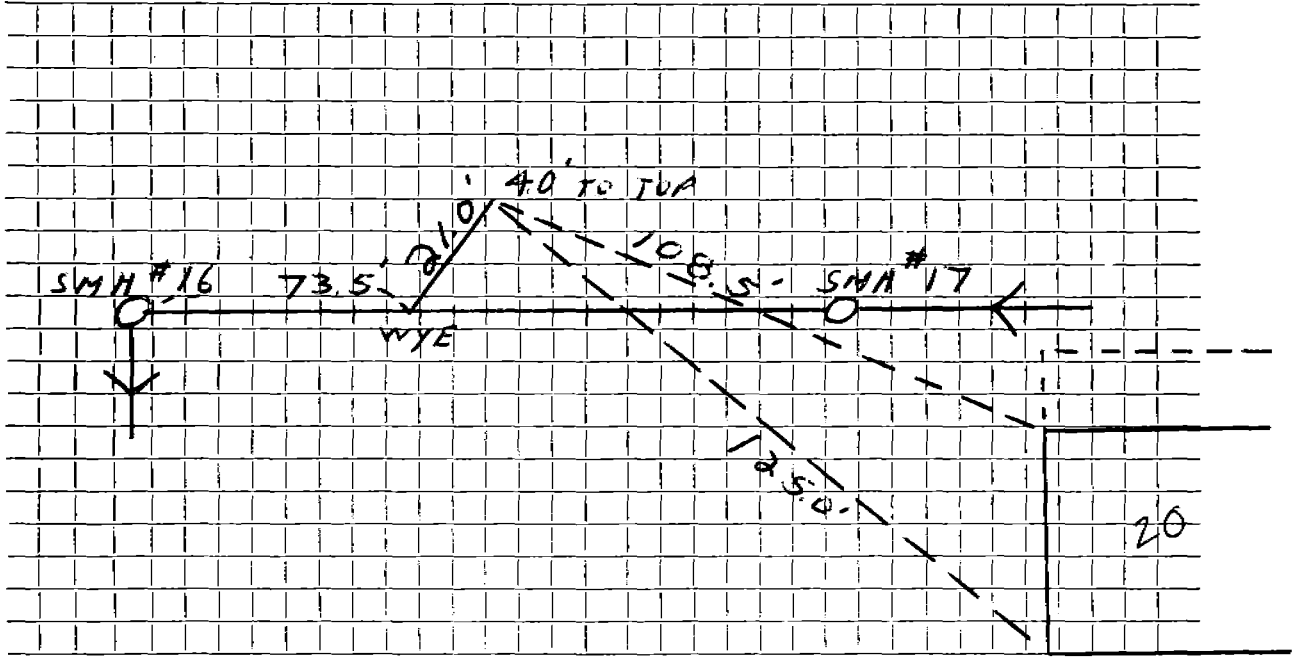

Connection made in Banks ..... Street.      Work completed .....

Remarks: .....  
.....  
.....