

Name

Service No.

Address #22-24 BANKS AVE

Location

Kind of Pipe AC

Size 6"

Size of Main 8"

Repair—Renewal—New Service

Location

Date

Material

Amount

Total

Date


Amount

8-18 75 21'-6" AC at 10.00 = 210.00

DATE \_\_\_\_\_

TOWN OF LEXINGTON — BOARD OF PUBLIC WORKS  
SEWER DIVISION

Sketch of Service Here **22+24**

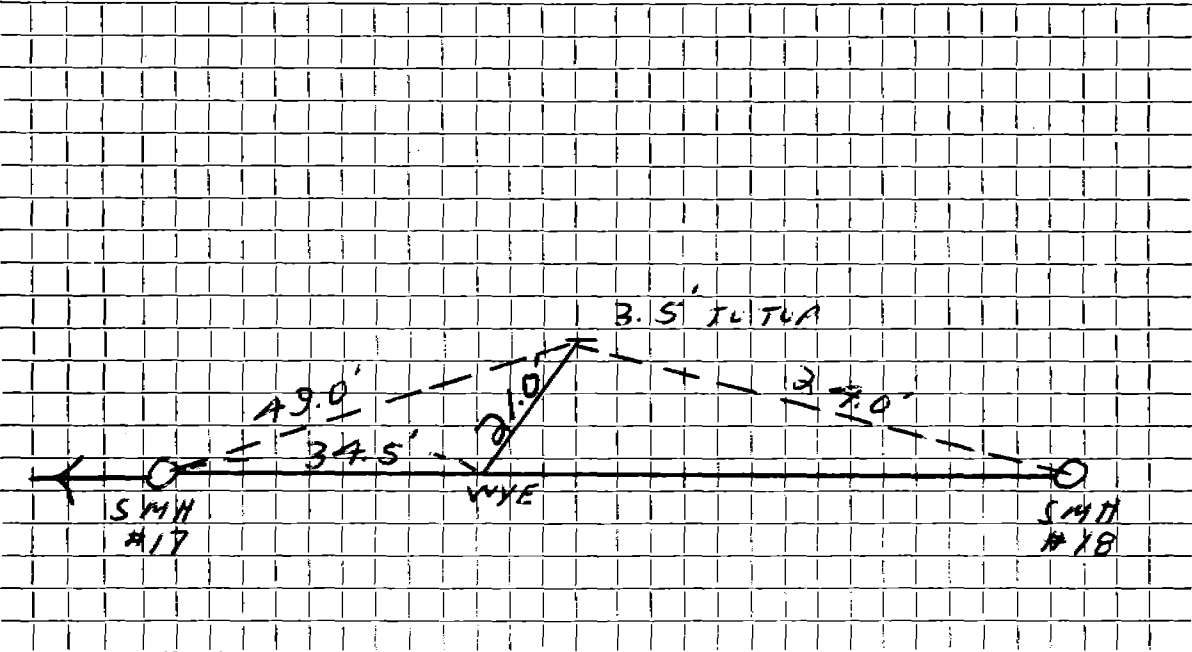

Connection made in Banks Street. Work completed .....

Remarks: .....  
.....  
.....