

Name Leo W. Harrington

Service No. 111

Address 33 Banks AVE.

Location

Kind of Pipe AC

Size 6"

Size of Main 8"

Repair—Renewal—New Service

J.M. Lucente Co. #2754

Location AUG 16 1976

Date	Material	Amount	Total	Date	Amount	
8-18 75	21'-6" AC at	\$10.00	= \$210.00	10/15/75	Deposit	210 00
10/23/75	16' 6" Transite Pipe					
	10' 4" Cast Iron Pipe					


P.B.K.18501

DATE _____

TOWN OF LEXINGTON — BOARD OF PUBLIC WORKS
SEWER DIVISION

Sketch of Service Here

33

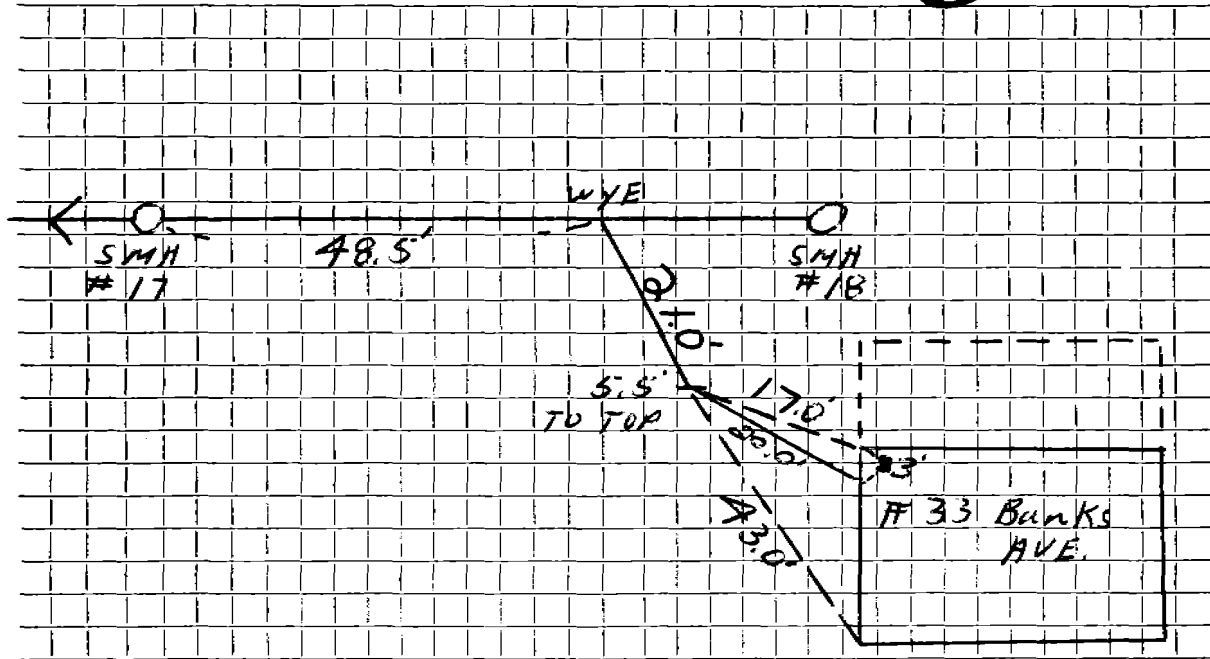

Connection made in ^{#33} Banks Ave Street. Work completed 10/23/75

Remarks:

.....

.....