


DATE _____

TOWN OF LEXINGTON — BOARD OF PUBLIC WORKS SEWER DIVISION

9 BANKS

Sketch of Service Here

9

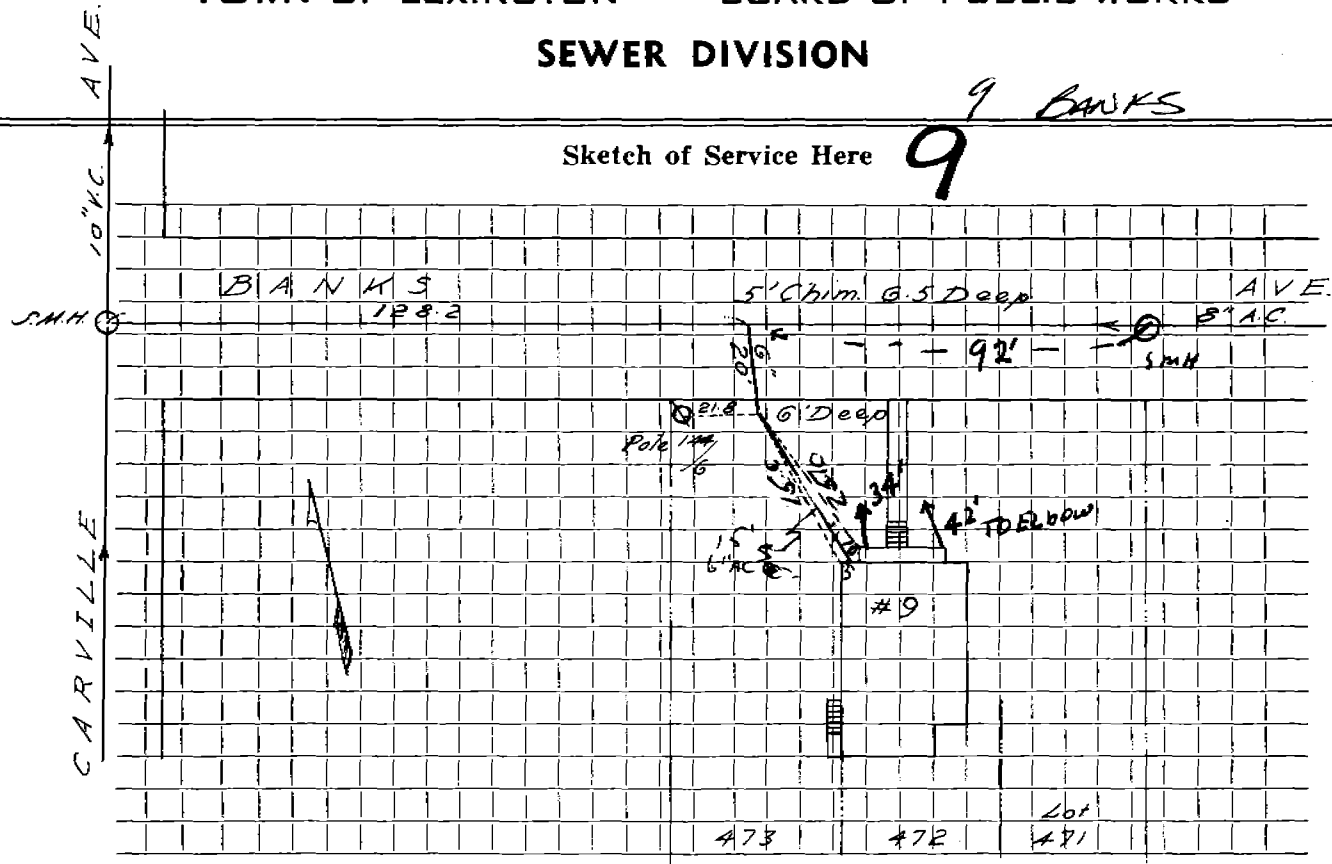

Connection made in Street. Work completed

Remarks: 12-2-90 9'6" PVC From ELbow To EDGE OF RD.

.....
.....