

Name Samuel Berman

Service No. 20

Address 11 Barberry Rd.

Location Lots L.C. 64 & L.C. 66

Kind of Pipe

Size

Size of Main


Repair—Renewal—New Service Valeri #2007

Location JUN 5 1972

Date	Material	Amount	Total	Date	Amount
1971	24' 6" A.C. transite pipe @ 12.00	288 00		3-30-22 Deposit	388 00
4-10-72	184' 6" Transite pipe				

DATE \_\_\_\_\_

# TOWN OF LEXINGTON — BOARD OF PUBLIC WORKS SEWER DIVISION

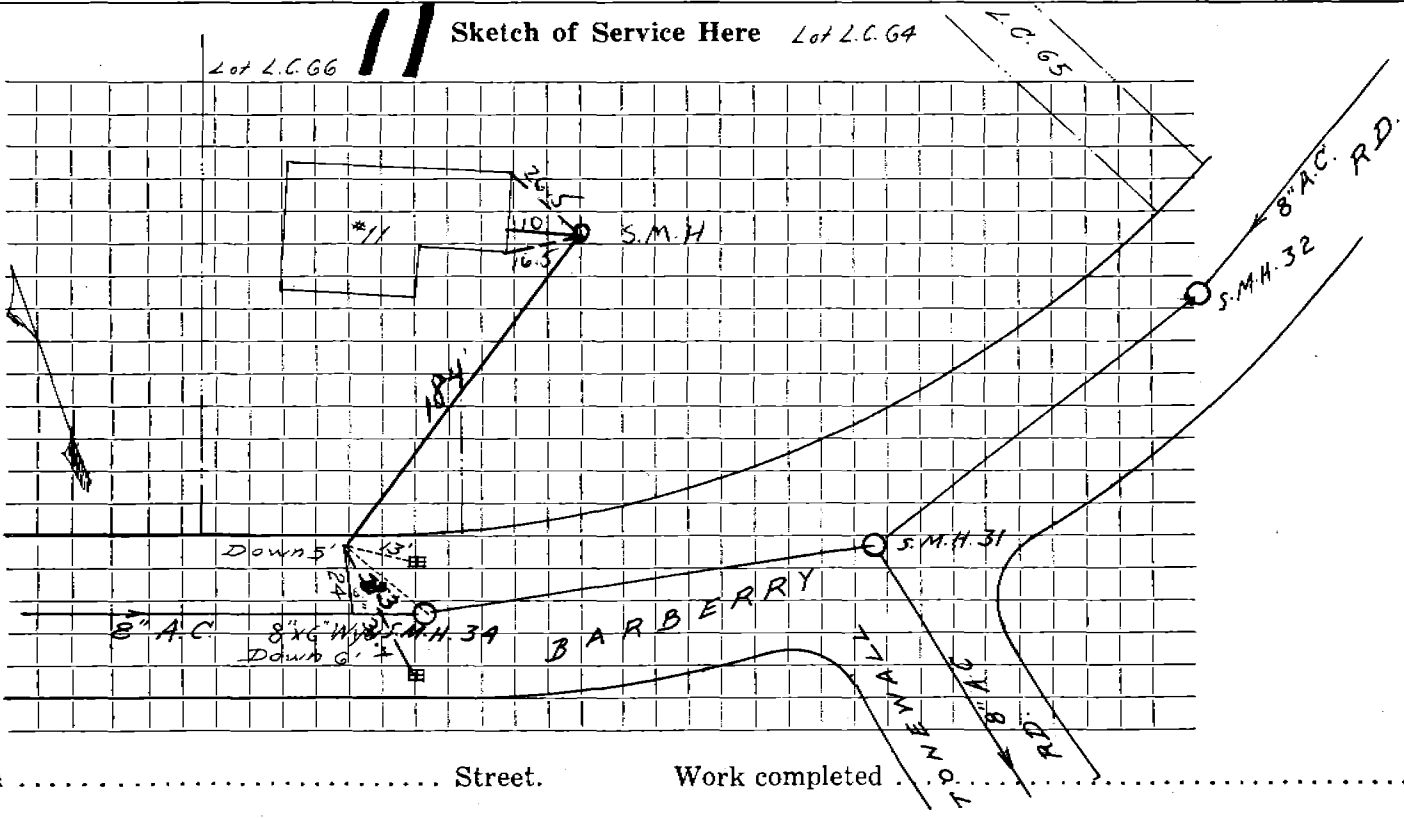

Connection made in ..... Street. Work completed .....

Remarks: .....  
.....  
.....