

Name *Janet Gendall*

Service No. *54*

Address *12 Barberry Rd.*

Location *Lot L.C. 25*

Kind of Pipe

Size

Size of Main

~~Repair~~ ~~Renewal~~ ~~New~~ Service *Valve # 3014*

Location *AUG 29 1977*


Date		Material	Amount		Total	Date	Amount	
<i>1971</i>	<i>27'</i>	<i>6" A.C. transite</i>				<i>7/26/77</i>	<i>Deposit</i>	<i>324.00</i>
		<i>pipe @ 12.00</i>	<i>324</i>	<i>00</i>				
	<i>7/27/77 53'</i>	<i>transite pipe</i>						
	<i>10'</i>	<i>4" cast iron</i>						

DATE \_\_\_\_\_

TOWN OF LEXINGTON — BOARD OF PUBLIC WORKS

SEWER DIVISION

Sketch of Service Here **12**

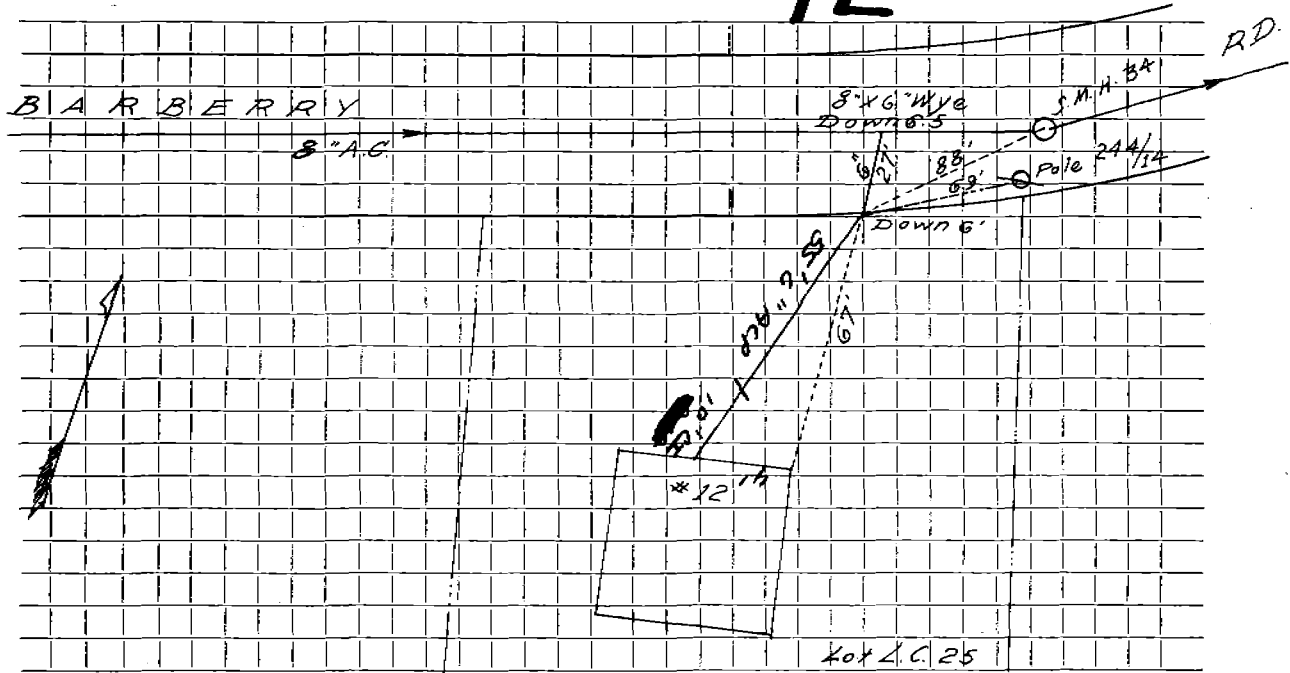

Connection made in ..... Street. Work completed .....

Remarks: .....  
.....  
.....