


DATE 5/20/92

TOWN OF LEXINGTON — BOARD OF PUBLIC WORKS
SEWER DIVISION

Sketch of Service Here **13**

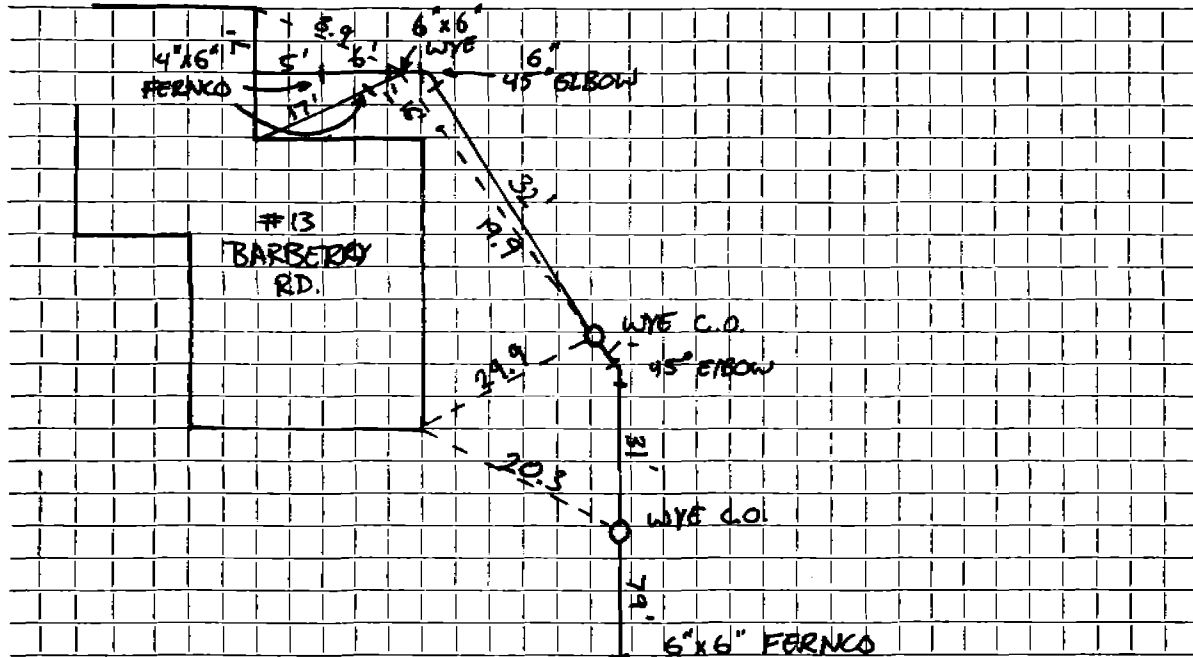

Connection made in Street. Work completed

Remarks: INSTALLED BY KIRKLAND & SHAW

INSPECTED BY C.R.G.