

Name Robert Rotberg

Service No. 43

Address 14 Barberrry Rd.

Location Lot L.C. 26

Kind of Pipe

Size

Size of Main

Repair—Renewal—New Service Valeri #2036

Location JUN 5 1972


Date		Material	Amount		Total	Date	Amount
1971	17'	6" A.C. transite pipe @ 12.00	204	00		4-18-72 Deposit	204 00
4-26-72	153'	6" Transite pipe					
	10'	4" Cast Iron pipe					

DATE _____

TOWN OF LEXINGTON — BOARD OF PUBLIC WORKS

SEWER DIVISION

Sketch of Service Here **14**

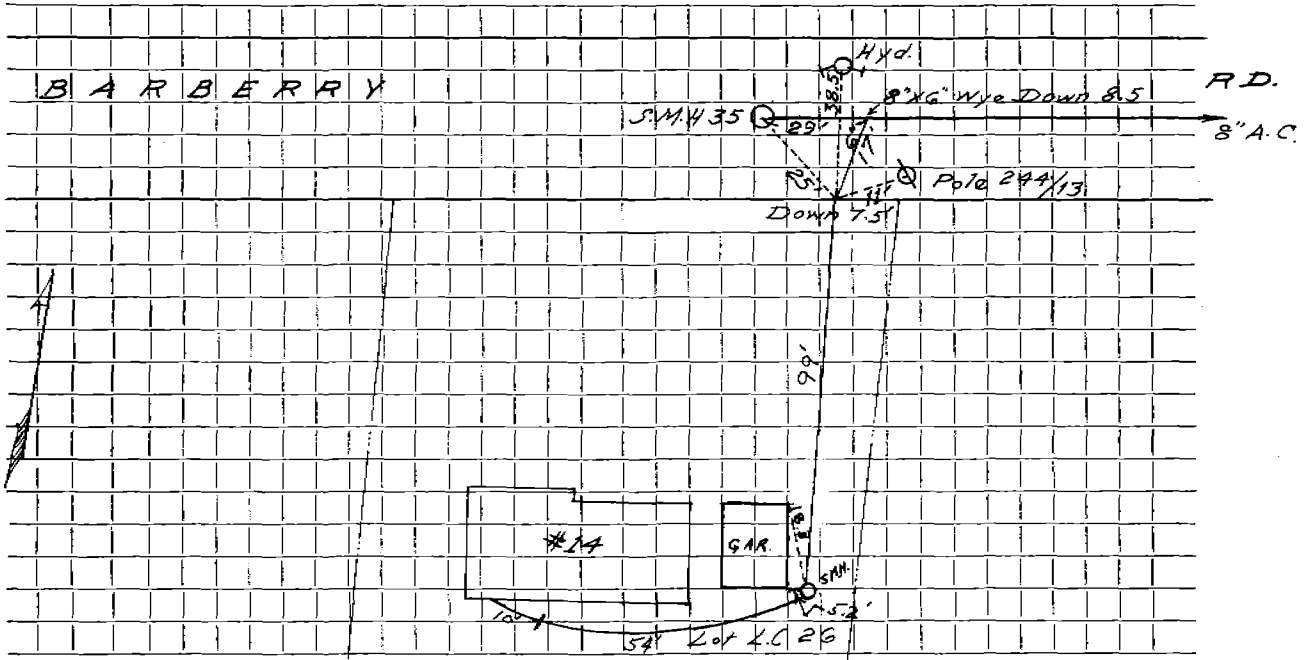

Connection made in Street. Work completed

Remarks:

.....

.....