

Name Aaron Galvin

Service No. 103

Address 15 Barberry Rd.

Location Lot 29

Kind of Pipe

Size

Size of Main

~~Repair - Renewal~~ New Service Trebino #1

Location DEC 9 1979

Date	Material	Amount	Total	Date	Amount
------	----------	--------	-------	------	--------

1971	23' 6" A.C. transite pipe @ 12.00	276 00		11-19-79	Deposit 276 00
------	-----------------------------------	--------	--	----------	----------------


11-26-79	85' 6" Transite pipe				
	15' 4" Cast Iron				

DATE \_\_\_\_\_

TOWN OF LEXINGTON — BOARD OF PUBLIC WORKS  
SEWER DIVISION

Sketch of Service Here  
L. C. Lot 29

15

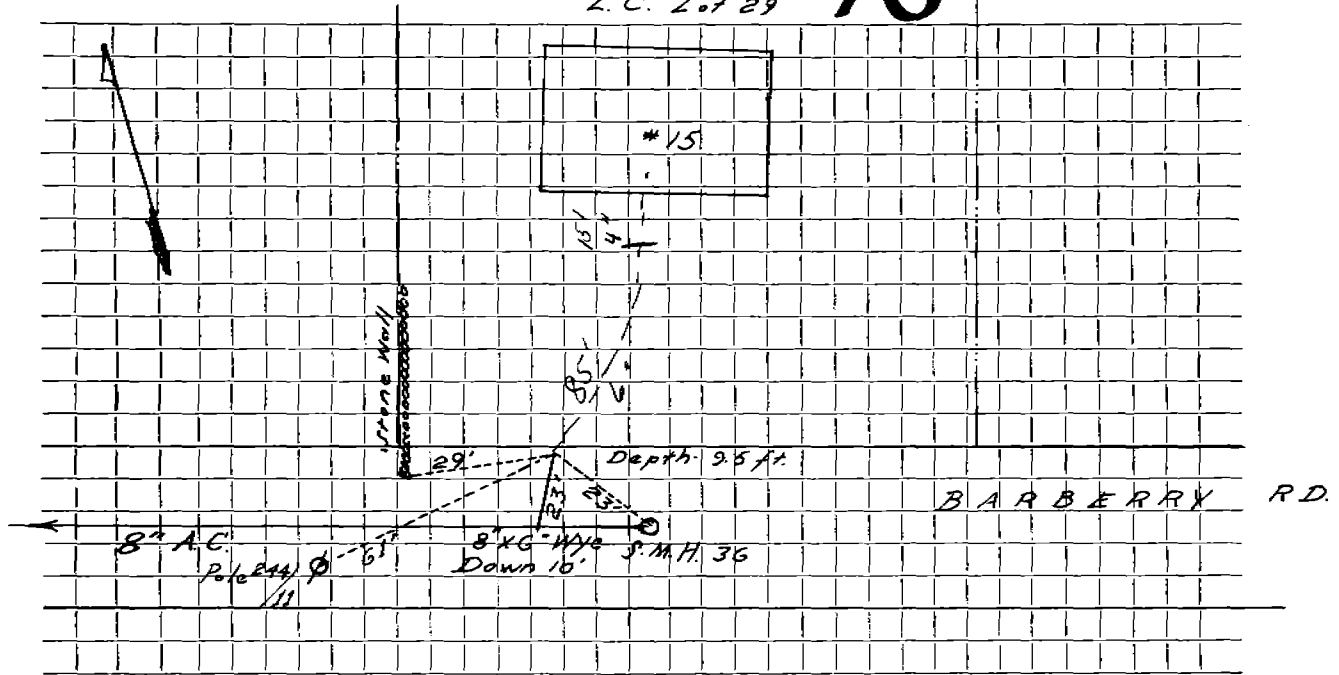

Connection made in ..... Street. Work completed .....

Remarks: .....  
.....  
.....