

Name Dr. John Robey

Service No. 107

Address 16 Barberry Road

Location

Kind of Pipe

Size

Size of Main

Repair—Renewal—New Service Valeri #107

Location AUG 14 1972

Date	Material	Amount	Total	Date	Amount
------	----------	--------	-------	------	--------


1971	18' 6" Transite pipe @12.00	216.00	216.00	11-10-71	Deposit 216.00
------	-----------------------------	--------	--------	----------	----------------

DATE _____

TOWN OF LEXINGTON — BOARD OF PUBLIC WORKS

SEWER DIVISION

Sketch of Service Here **16**

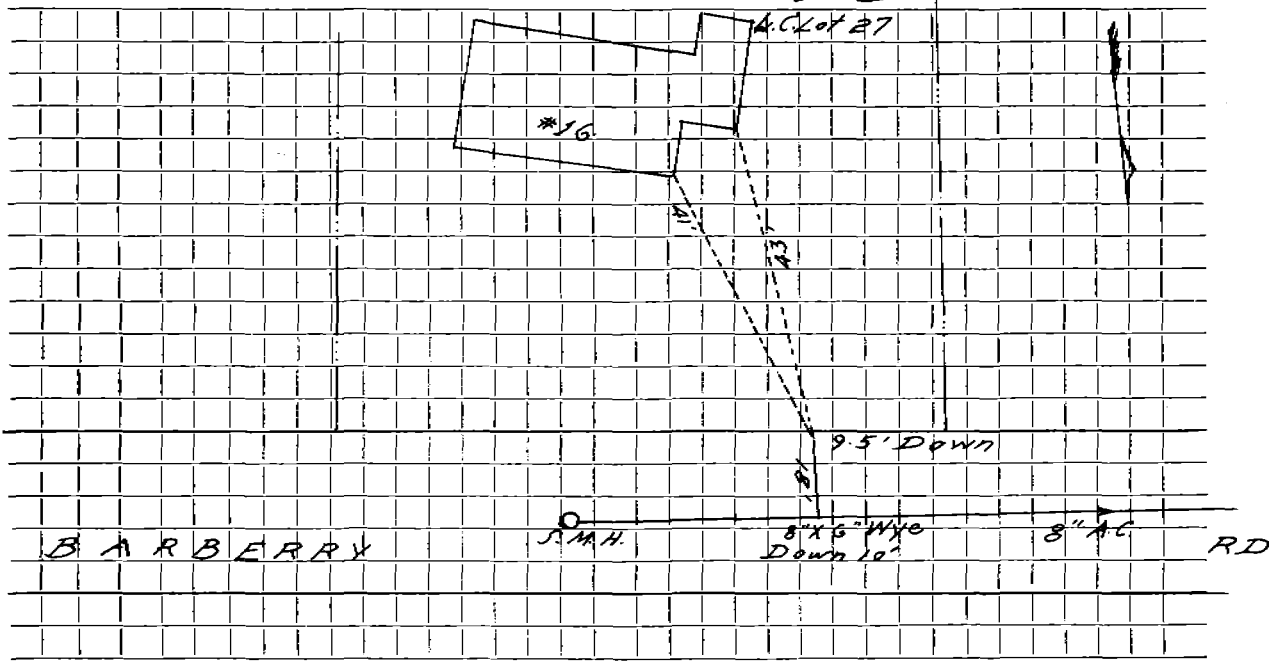

Connection made in Street. Work completed

Remarks:
.....
.....