

Name Hideo Sasaki

Service No. 110

Address 17 Barberry Road

Location

Kind of Pipe

Size

Size of Main

Repair—Renewal—New Service Valeri#1963

Location AUG 14 1972


Date	Material	Amount	Total	Date	Amount
1972 5 25'	6" Transite pipe @12.00		300.00	11-11-71	Deposit 300.00

DATE _____

TOWN OF LEXINGTON — BOARD OF PUBLIC WORKS

SEWER DIVISION

Sketch of Service Here **17**

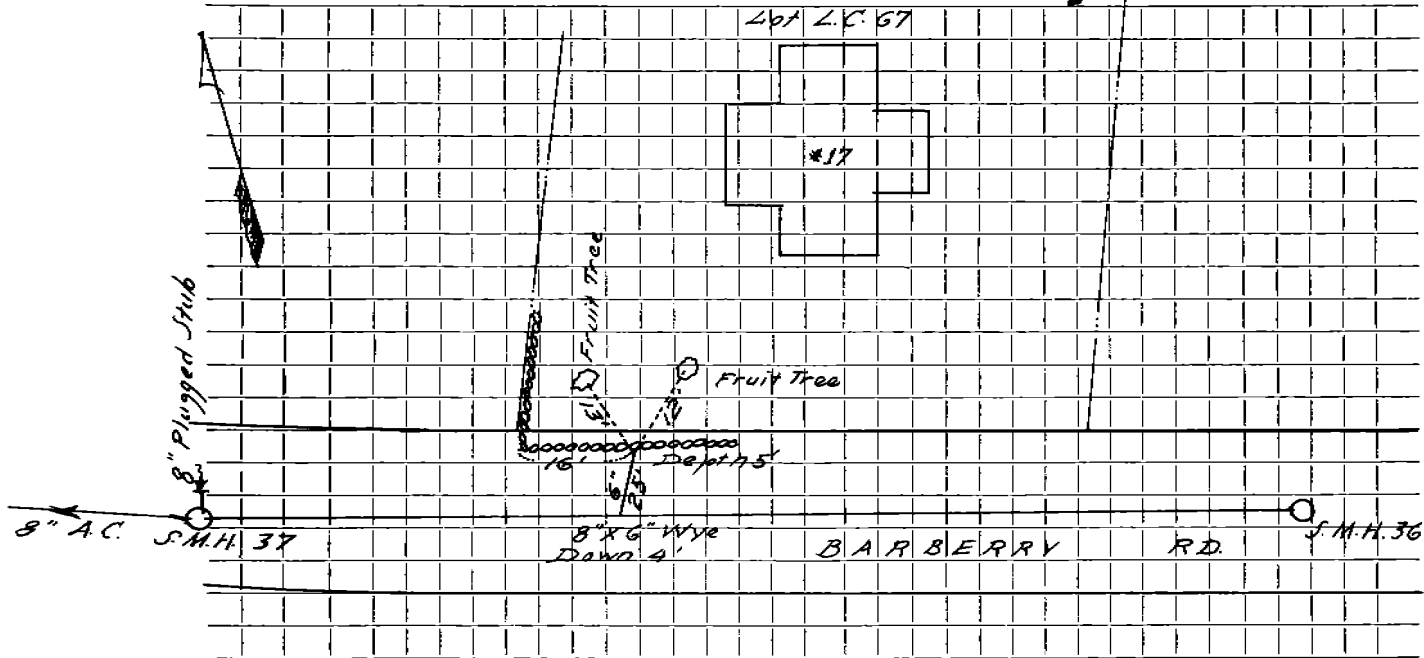

Connection made in Street. Work completed

Remarks:
.....
.....