

Name L. J. Bakanowsky

Service No. 2

Address 2 Barberry Rd.

Location Lot L.C. 73

Kind of Pipe

Size

Size of Main

~~Capacity Renewal~~ New Service Valeri #3481


Location JUN 23 1980

Date	Material	Amount	Total	Date	Amount
1971	31' 6" A.C. transite pipe @ 12.00	372 00		2-11-80	372.00
2-12-80	108' 6" Transite pipe				
	6' 4" Cast Iron pipe				

DATE _____

TOWN OF LEXINGTON — BOARD OF PUBLIC WORKS
SEWER DIVISION

Sketch of Service Here **2**

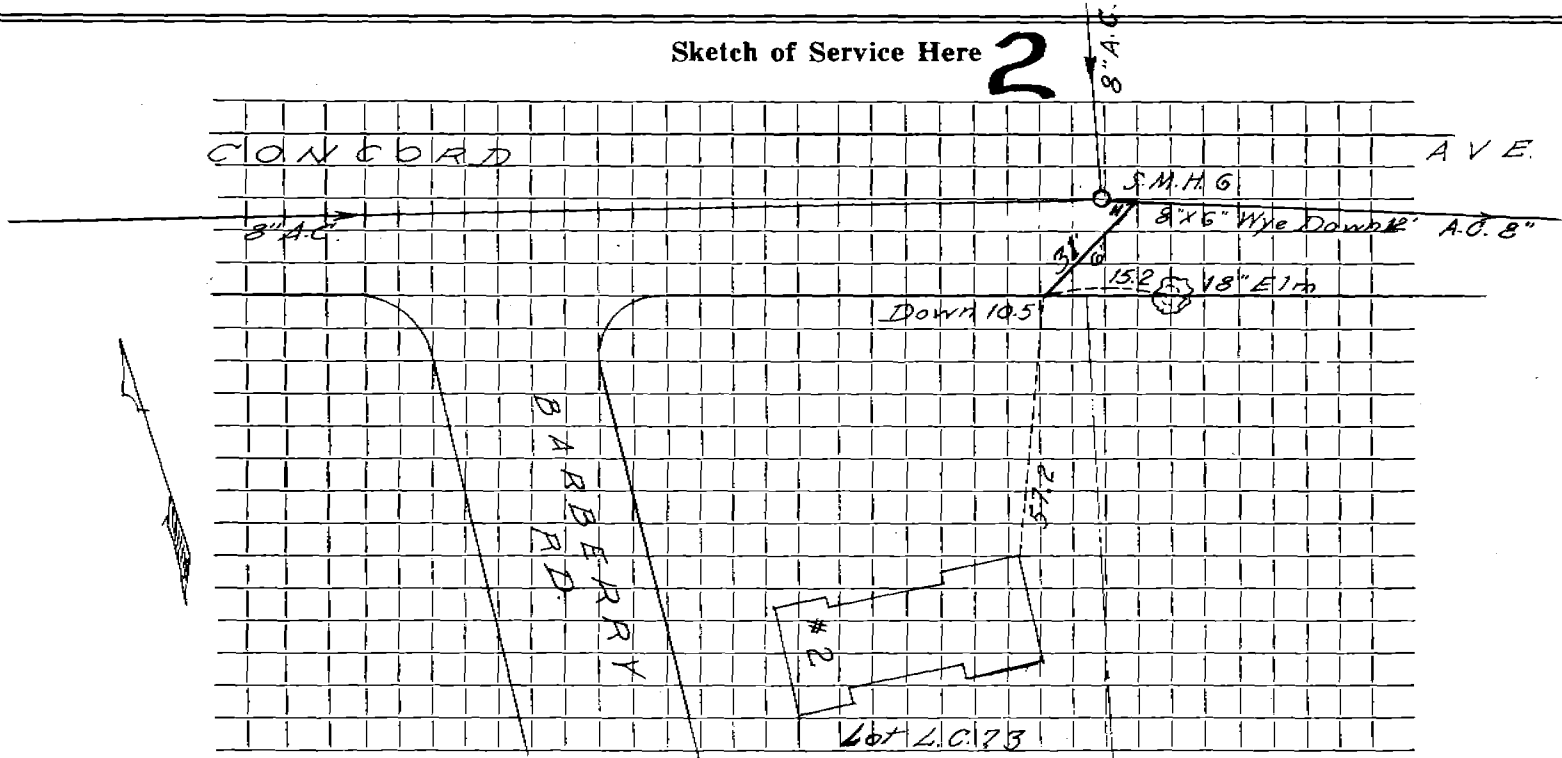

Connection made in Street. Work completed

Remarks:
.....
.....