


DATE 10/26/90

TOWN OF LEXINGTON — BOARD OF PUBLIC WORKS PAB

SEWER DIVISION

Sketch of Service Here **20**

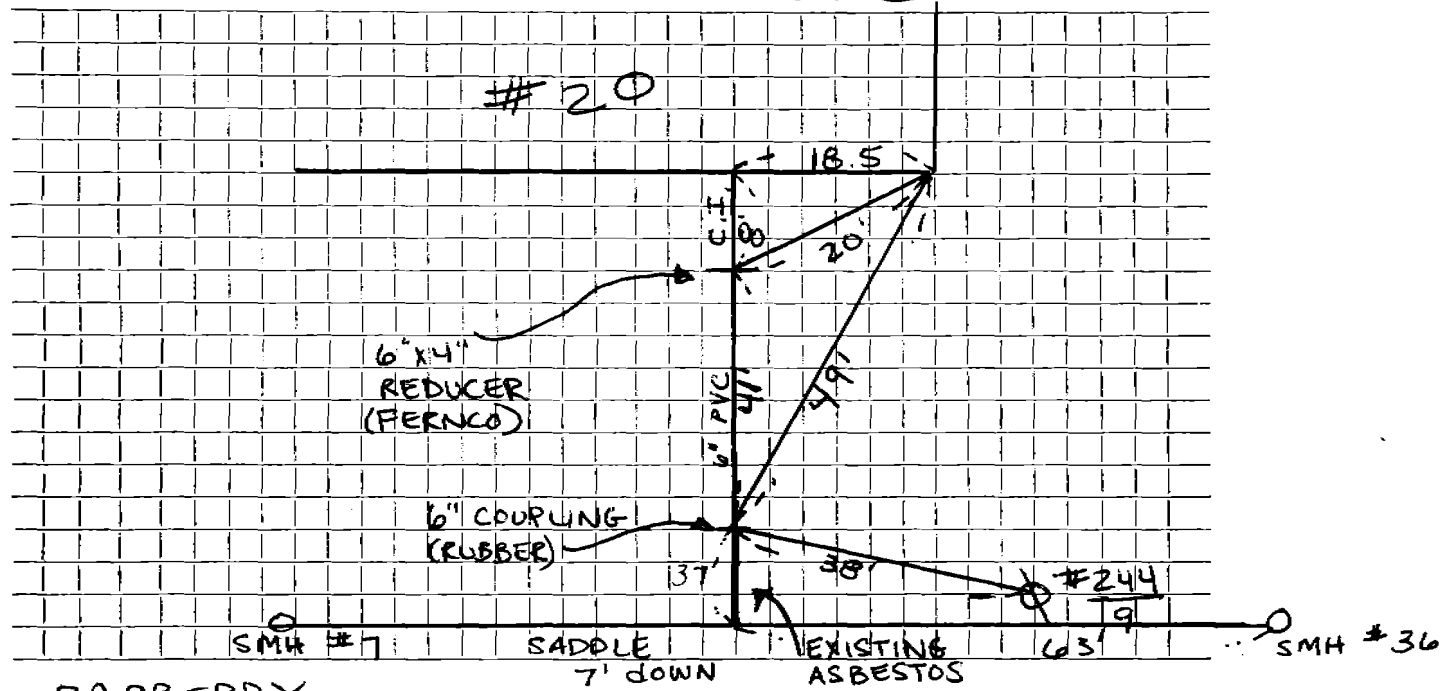

Connection made in BARBERRY Street. Work completed

Remarks: INSPECT - PAB
CONTRACTOR: SCIRE