

Name

Service No.

Address

21 Barberry Rd. (pool)

Location Lot L.C. 65

Kind of Pipe

Size

Size of Main

Repair—Renewal—New Service

Location

Date

Material

Amount

Total

Date

Amount

1971

27'


6" A.C. transite

pipe @ 12.00

324 00

DATE \_\_\_\_\_

TOWN OF LEXINGTON — BOARD OF PUBLIC WORKS  
SEWER DIVISION

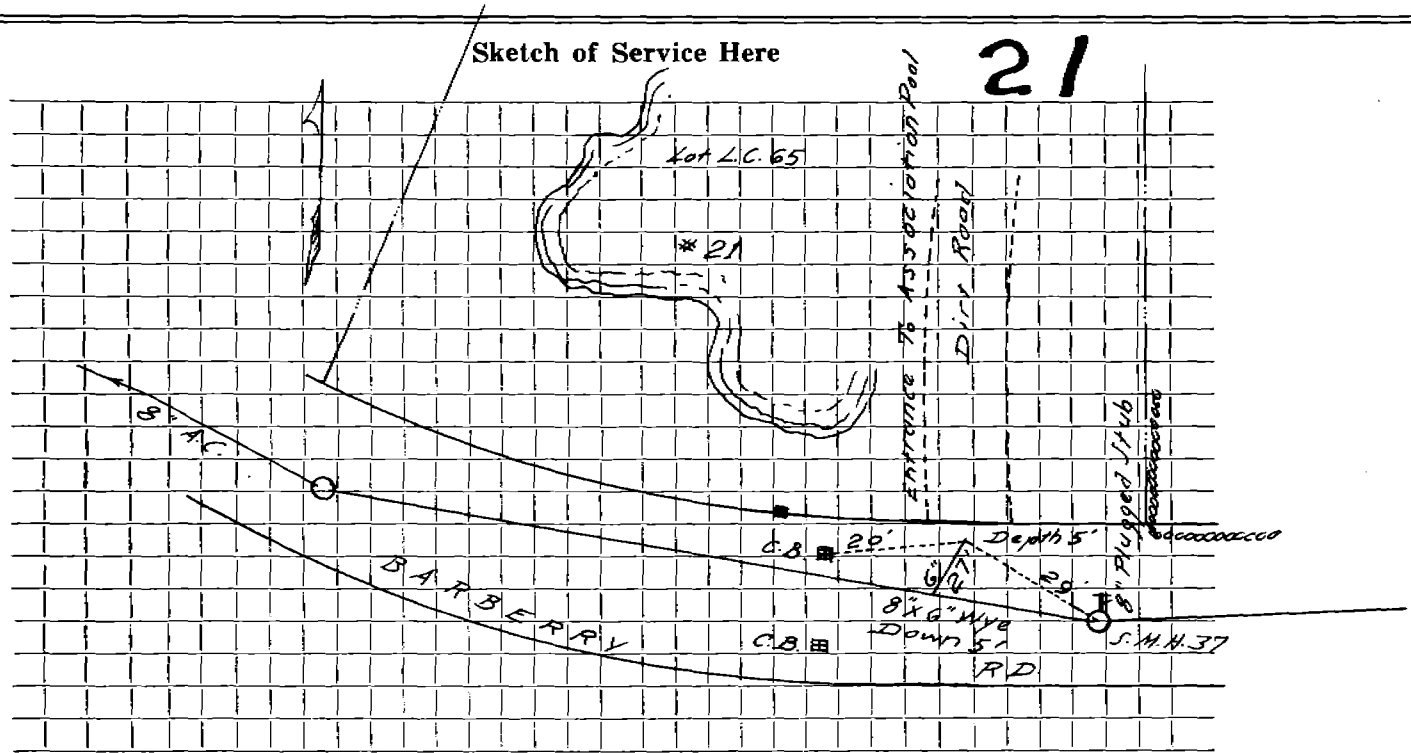

Connection made in ..... Street. Work completed .....

Remarks: .....  
.....  
.....