

Name Peter Richman

Service No. 99

Address 22 Barberry Road

Location

Kind of Pipe

Size

Size of Main

Repair—Renewal—New Service Bonanno #1953

Location

AUG 14 1972


Date	Material	Amount	Total	Date	Amount
------	----------	--------	-------	------	--------

1971	16 6" Transite pipe @	12.00	192.00	11-3-71	Deposit	192.00
------	-----------------------	-------	--------	---------	---------	--------

DATE _____

TOWN OF LEXINGTON — BOARD OF PUBLIC WORKS
SEWER DIVISION

Sketch of Service Here **22**

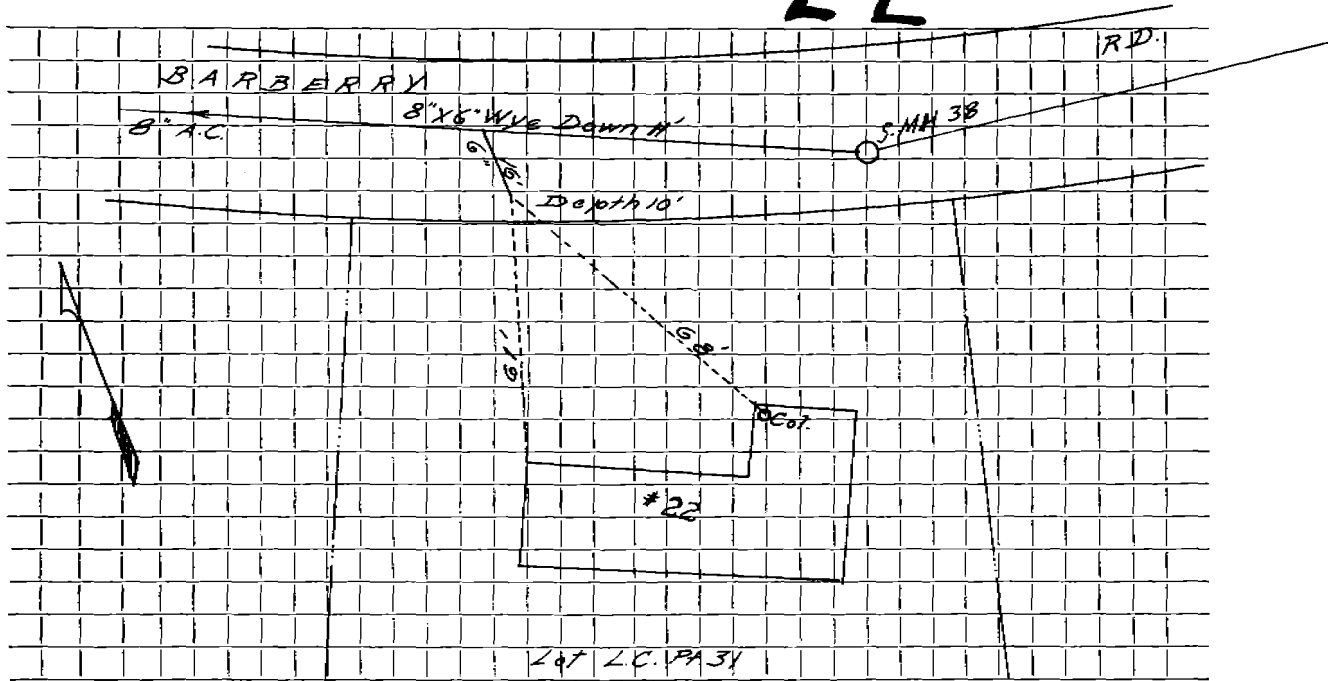

Connection made in Street. Work completed

Remarks:
.....
.....