

Name Otto Ekstein

Service No. 93

Address 24 Barberrry Road

Location Lot Pt. L.C. 32

Kind of Pipe

Size

Size of Main

Repair—Renewal—New Service Valeri #1935


Location AUG 14 1972

Date	Material	Amount	Total	Date	Amount
1971	20' 6" Transite pipe @12.00		240.00	11-1-71	Deposit
					240.00

DATE _____

TOWN OF LEXINGTON — BOARD OF PUBLIC WORKS

SEWER DIVISION

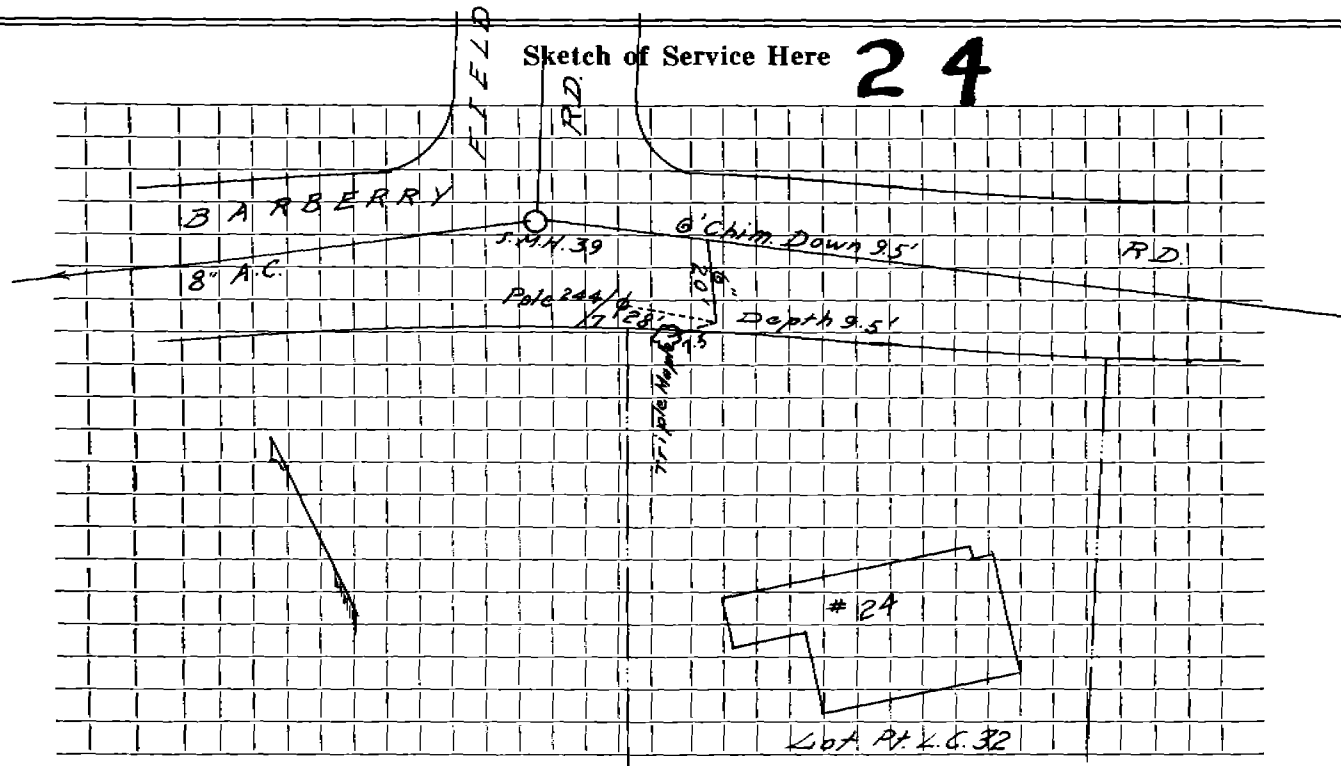

Connection made in Street. Work completed

Remarks:

.....
.....