

Name Dr. Norman Paul

Service No. 108

Address 26 Barberry Road

Location

Kind of Pipe

Size

Size of Main

Repair—Renewal—New Service Valeri #1950

Location AUG 14 1972

Date	Material	Amount	Total	Date	Amount
------	----------	--------	-------	------	--------

1971	15' 6" Transite pipe @	2.00	180.00	11-10-71	Deposit 180.00
------	------------------------	------	--------	----------	----------------


DATE \_\_\_\_\_

TOWN OF LEXINGTON — BOARD OF PUBLIC WORKS

SEWER DIVISION

Sketch of Service Here

26

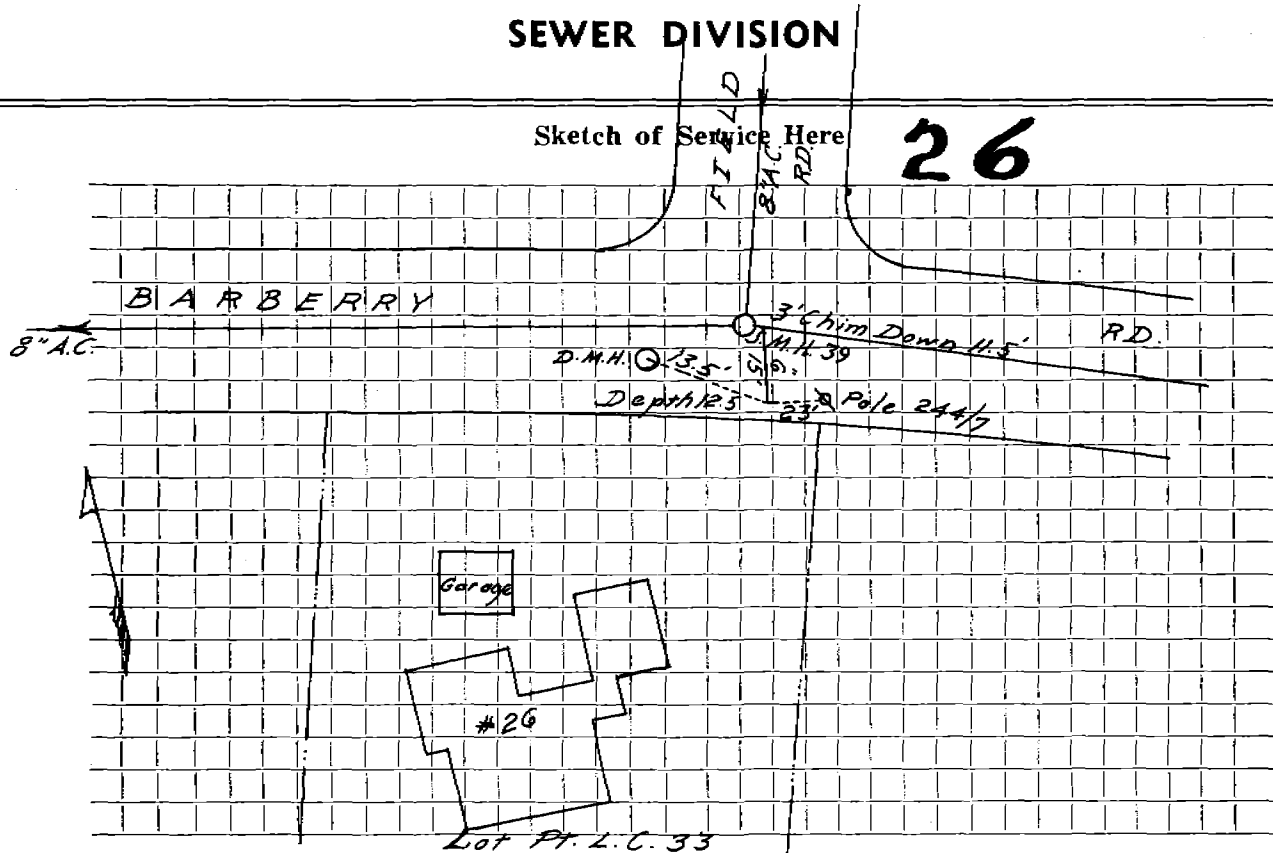

Connection made in ..... Street. Work completed .....

Remarks: .....  
.....  
.....