

Name Hubert F. Gordon

Service No. 96

Address 30 Barberrry Rd.

Location Lot Pt. L.C. 35

Kind of Pipe

Size

Size of Main

Repair—Renewal—New Service

Bonanno # 1936

Location

Date

Material

Amount

Total

Date

Amount

1971

22'-6" ACP

12.00

264.00

11-2-71

Deposit

264.00

11-30-71

186'-6" ACP


10'-4" C.I.

DATE \_\_\_\_\_

TOWN OF LEXINGTON — BOARD OF PUBLIC WORKS  
SEWER DIVISION

**30** Sketch of Service Here

# 30 Barbary Rd.

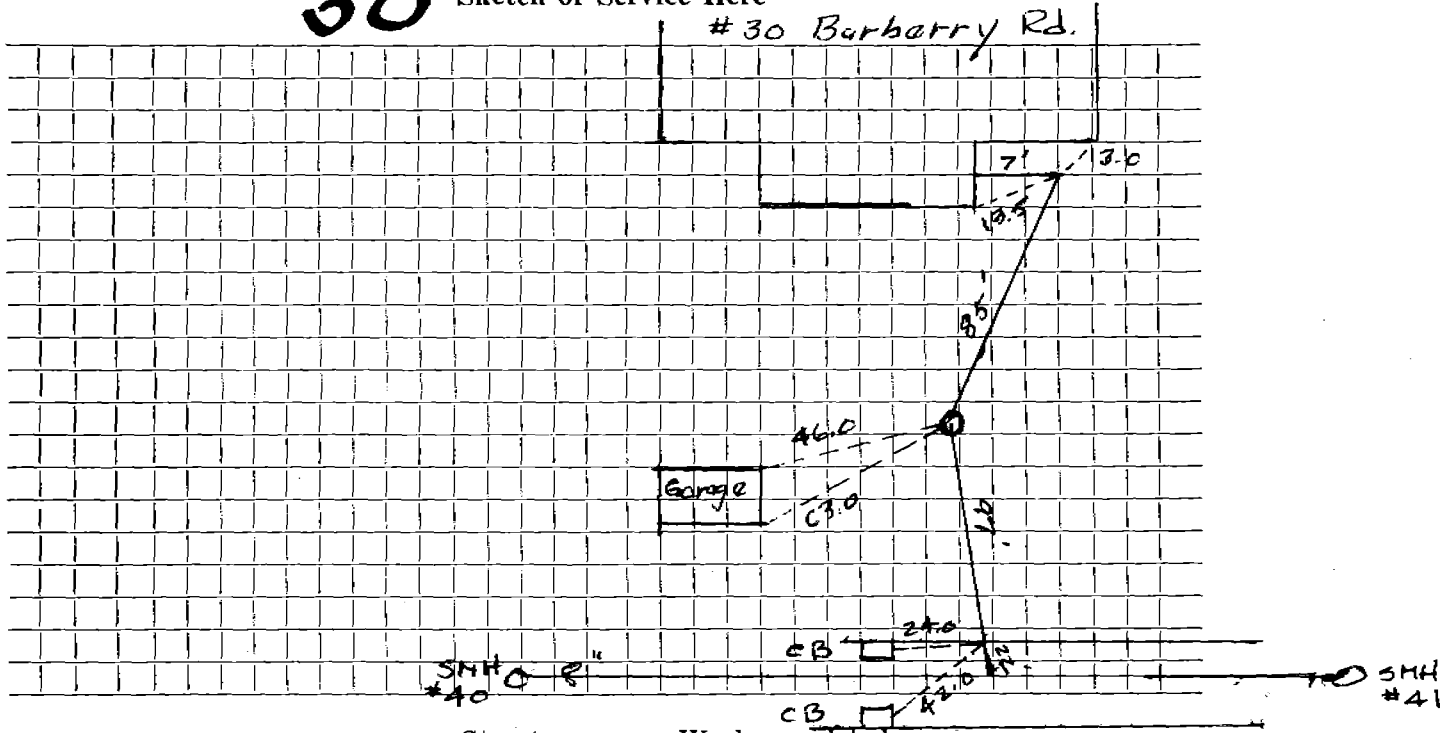

Connection made in ..... Street. Work completed .....

Remarks: .....  
.....  
.....