

Name Robert Bicknell

Service No. 98

Address 32 Barberry Road

Location Lot Pt. L.C. 36

Kind of Pipe

Size

Size of Main

Repair—Renewal—New Service

Lexington Sewerage #1941

Location APR 26 1972

Date	Material	Amount	Total	Date	Amount
------	----------	--------	-------	------	--------

1971	25'	6" Transite pipe @12.00	300.00	11-3-71	Deposit	300.00
------	-----	-------------------------	--------	---------	---------	--------


11-15-71	83'	6" Transite pipe				
----------	-----	------------------	--	--	--	--

	10'	4" Cast Iron pipe				
--	-----	-------------------	--	--	--	--

DATE _____

TOWN OF LEXINGTON — BOARD OF PUBLIC WORKS
SEWER DIVISION

Sketch of Service Here **32**

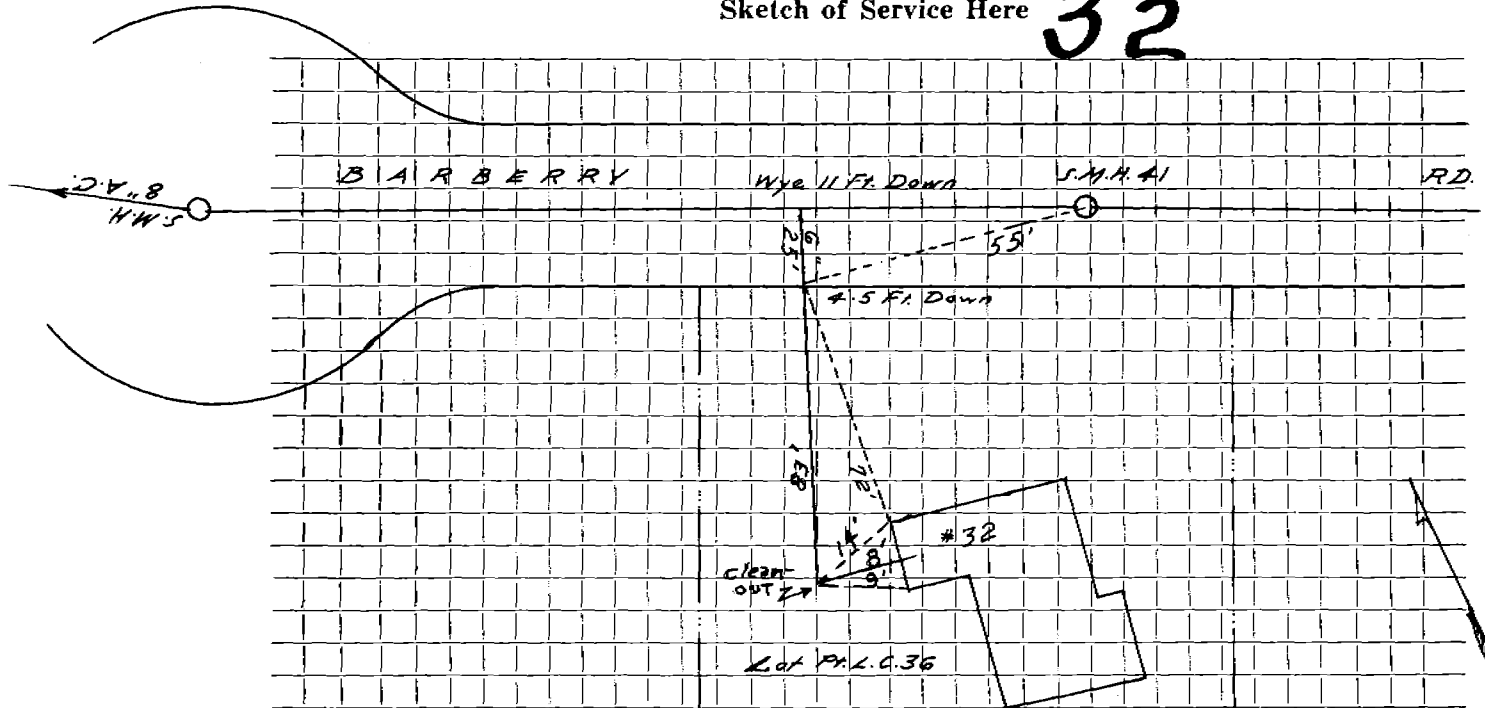

Connection made in Street. Work completed

Remarks:

.....
.....