

Name *David S. Gray*

Service No. *102*

Address *33 Barberry*

Location *Lot L.C. 40*

Kind of Pipe

Size

Size of Main

Repair—Renewal—New Service *Lex. Sewerage # 1938*

Location


Date		Material	Amount		Total		Date		Amount	
<i>1971</i>		<i>23' - 6" ACP</i>	<i>12,00</i>		<i>276,00</i>		<i>11-5-71</i>	<i>Deposit</i>	<i>276,00</i>	
<i>11-16</i>	<i>71</i>	<i>145' - 6" ACP</i>								
		<i>10' - 4" CI</i>								

DATE _____

TOWN OF LEXINGTON — BOARD OF PUBLIC WORKS

SEWER DIVISION

Sketch of Service Here **33**

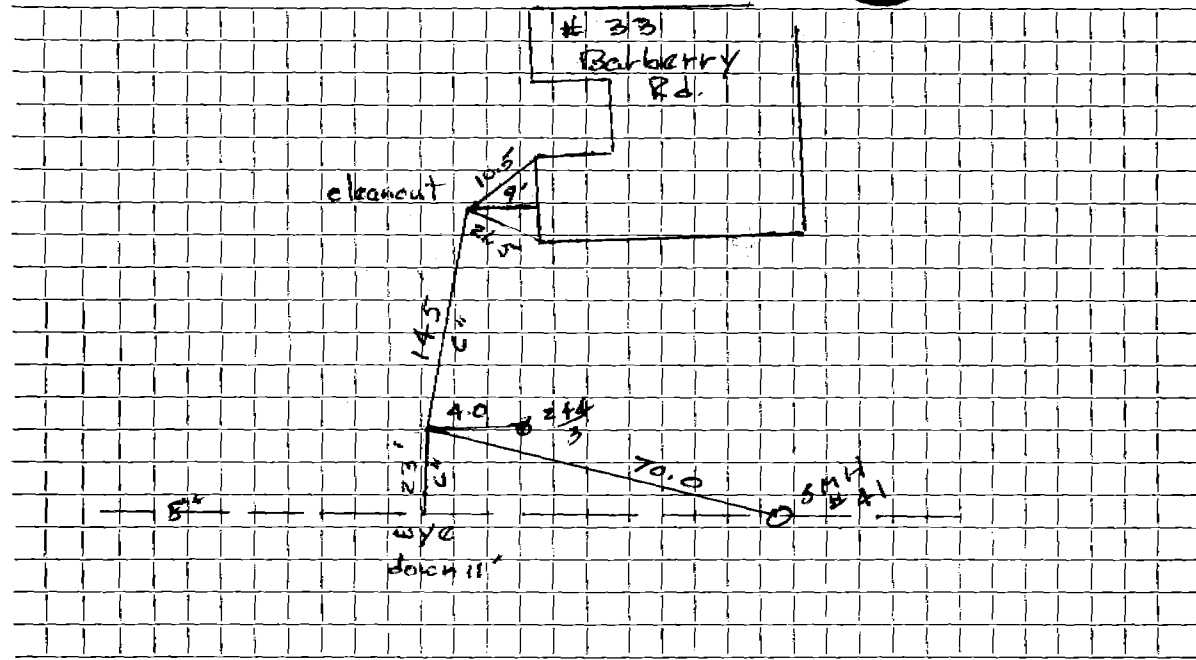

Connection made in Street. Work completed

Remarks:
.....
.....