

Name Eric Teicholz

Service No.

Address 34 Barberry Road

Location Lot PT. L.C. 37

Kind of Pipe

Size

Size of Main

Repair—Renewal—New Service Valeri #2362

Location

Date		Material	Amount	Total	Date	Amount	
1971		No Previous charge - easement					
10/13/73	104'	6" Transite pipe					
		10' 4" Cast Iron pipe					
10/7/87	120	5' 6" P.V.C. pipe (Grecci #4991)					
		10' 4" P.V.C. pipe					
		1 4 x 6 P.V.C. Fernco					
		2 22½ <sup>o</sup> Couplings					
		2 Precast manholes					
		2 Sewer manhole frame & covers					

DATE \_\_\_\_\_

TOWN OF LEXINGTON — BOARD OF PUBLIC WORKS



SEWER DIVISION

SMH  
○

SMH  
○

Sketch of Service Here **34**

BARBERRY RD

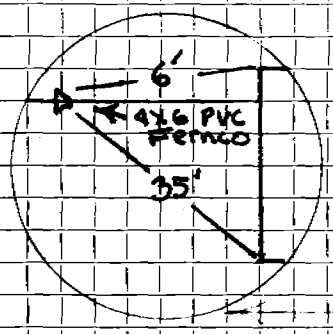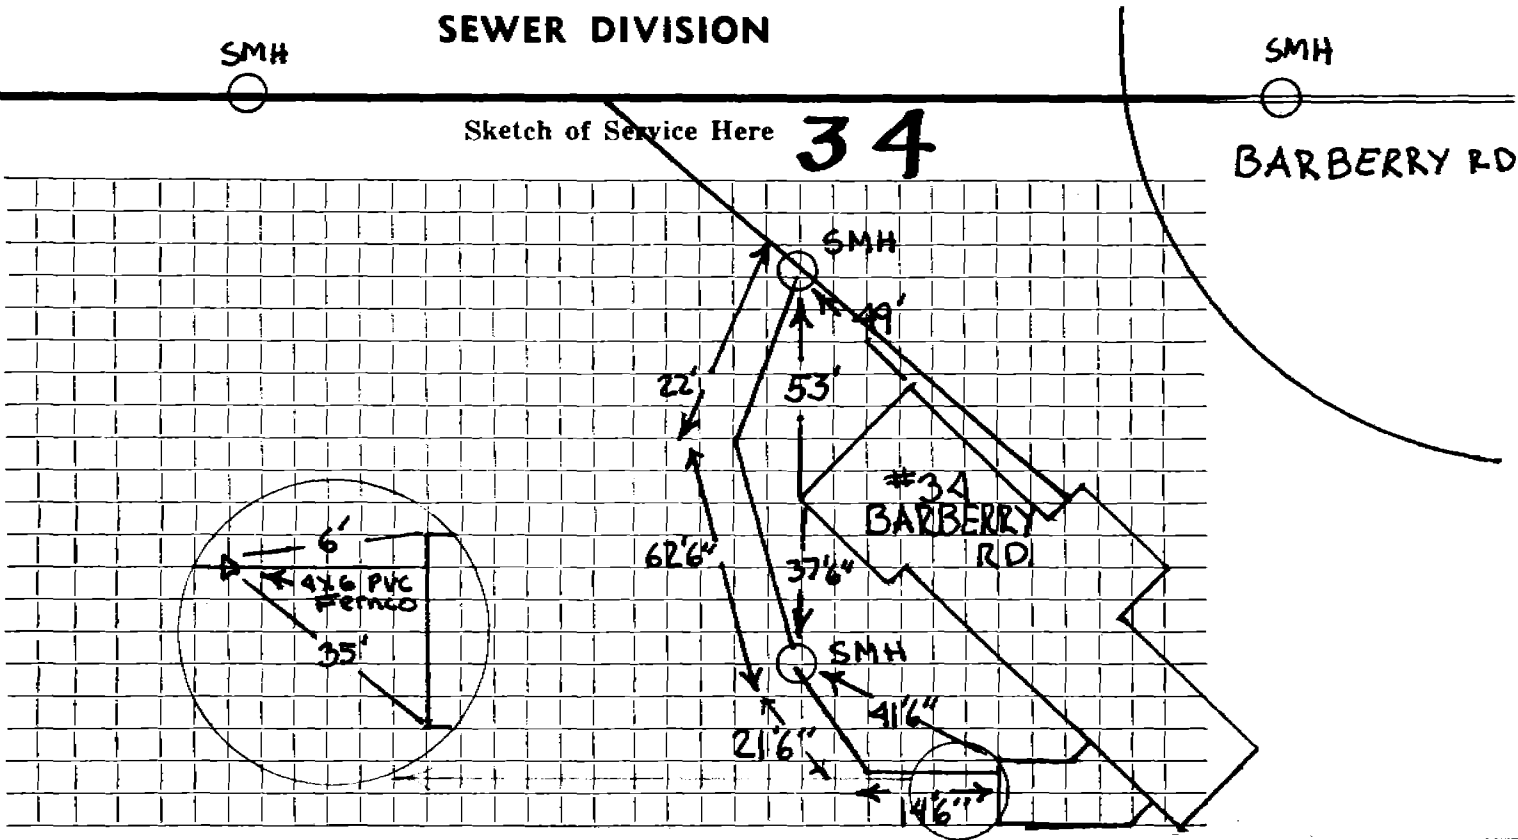

Connection made in ..... Street. Work completed .....

Remarks: .....  
.....  
.....