

Name Jack Wallens

Service No. 116

Address 35 Barberry Road

Location Lot L.C. 39

Kind of Pipe

Size

Size of Main


Repair—Renewal—New Service Valeri #1970

Location APR 26 1972

Date	Material	Amount	Total	Date	Amount	
1971 11-18-71	28' 6" Transite pipe @12.00		336.00	11-18-71	Deposit	336.00
12-1-71	150' 6" Transite pipe					
	20' 4" Cast Iron pipe					

DATE \_\_\_\_\_

TOWN OF LEXINGTON — BOARD OF PUBLIC WORKS  
SEWER DIVISION

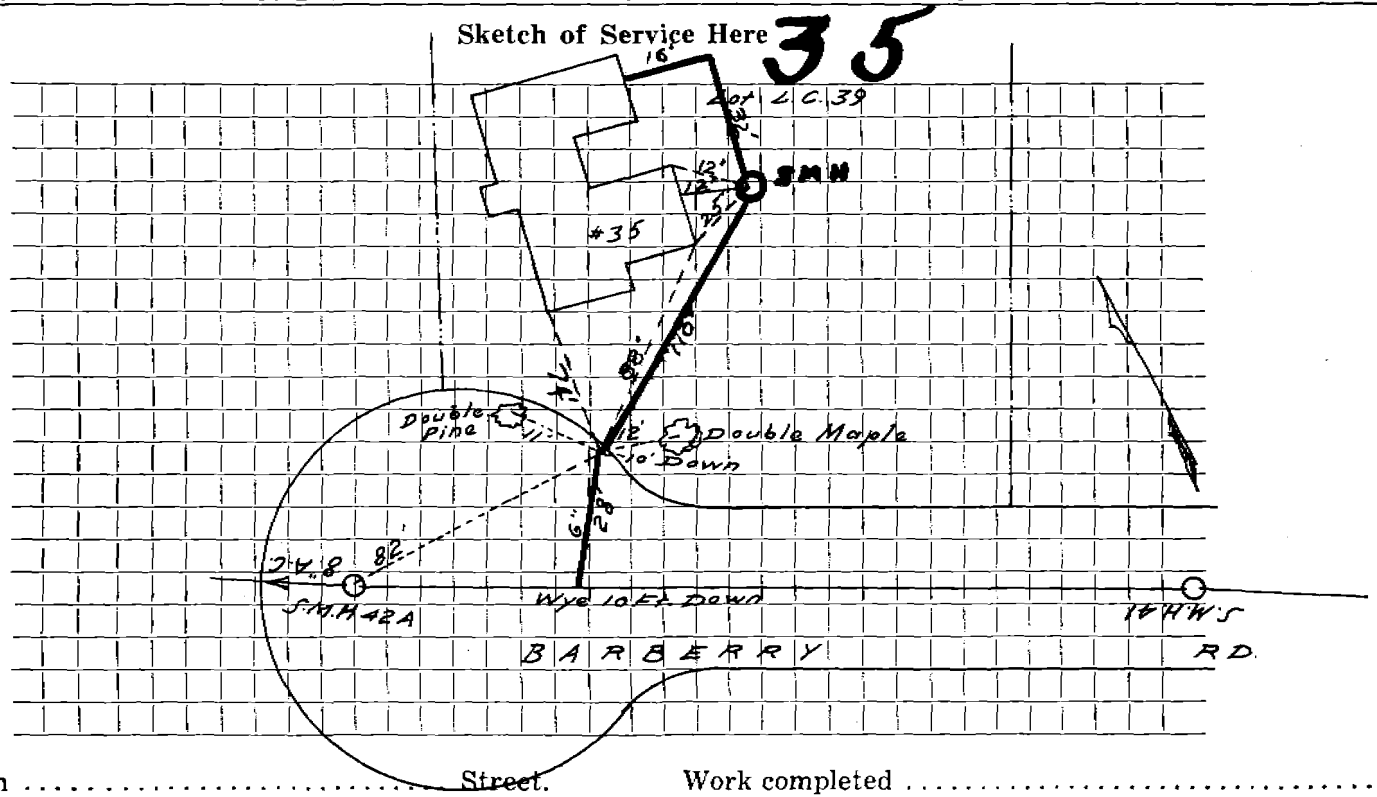

Connection made in ..... Street. Work completed .....

Remarks: .....  
.....  
.....